
Escalator

The MEP services and ceiling framing support below the escalator area to be coordinated properly.
- The ceiling structural supports for MEP services below the escalator area to be submitted separately.

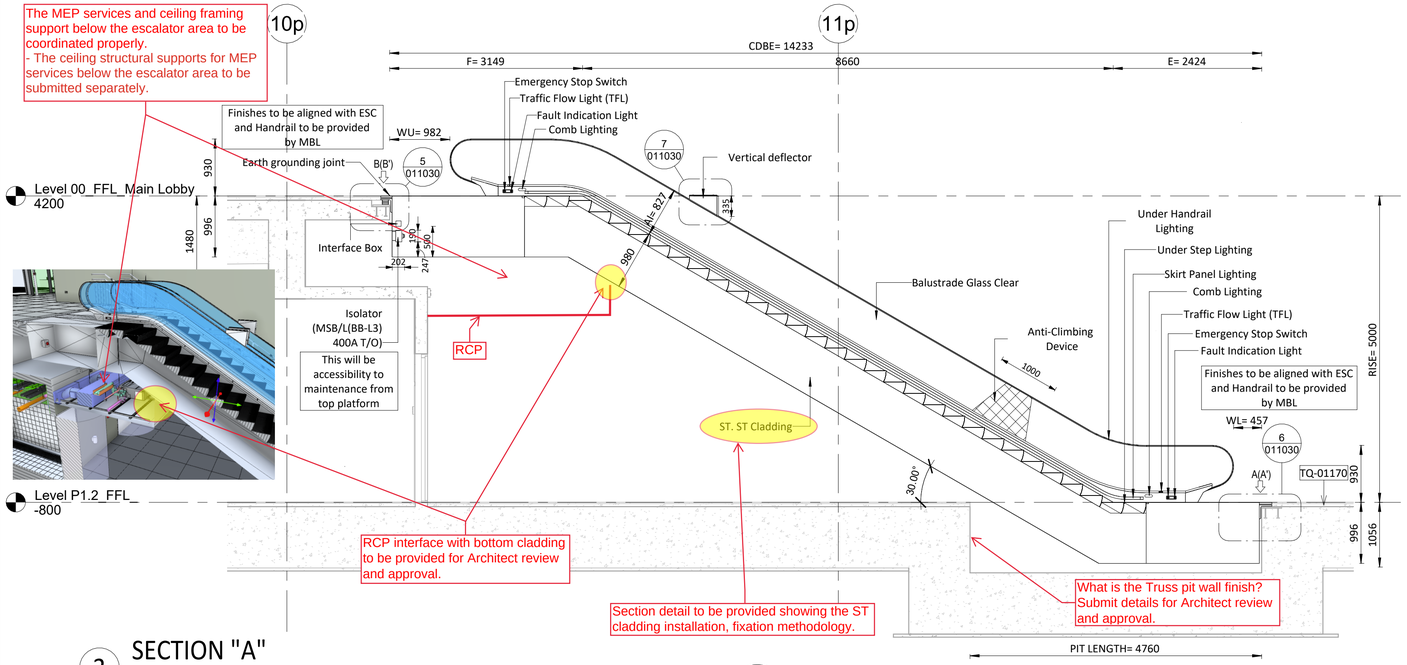


RCP interface with bottom cladding to be provided for Architect review and approval.


Section detail to be provided showing the ST cladding installation, fixation methodology.

What is the Truss pit wall finish? Submit details for Architect review and approval.


3 SECTION "A"
1 : 50

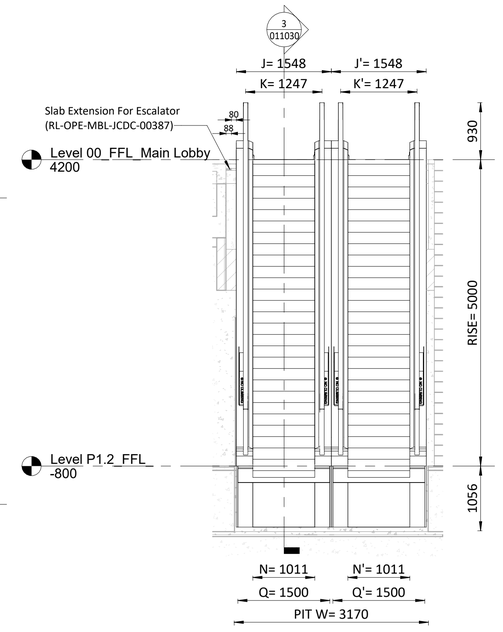

4 SECTION "B"
1 : 50

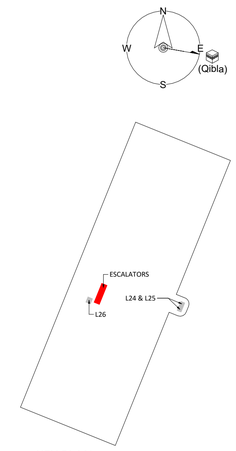

KEY PLAN

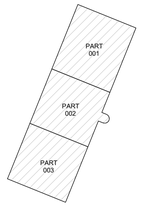


KEY PLAN


GENERAL NOTES: ALL LEVELS SHOWN ON THE DRAWING ARE CHART DATUM LEVELS PROJECT LEVEL+0.000 = +2.00 CHART DATUM.

DRAWING / DOCUMENT REFERENCE

NO.	NUMBER	TITLE	REV.
01	JOH-BHC-S4-01-015-XXX-DS-SPC-GN-0014	DIVISION 14 - CONVEYING EQUIPMENT	F00
02	JOH-BHC-S4-01-015-XXX-XX-DR-VT-015001	PARKING VERTICAL TRANSPORTATION LIFT MATRIX	
03	JOH-BHC-S4-01-015-XXX-ZZ-DR-VT-013003	PARKING VERTICAL TRANSPORTATION ESCALATORS #E1 AND #E2 SECTION	
04	TQ-OPE-MBL-JCDC-00950	CAR PARK PART-002 LEVEL 00 BEAM ADDED AND SLAB EXTENSION FOR ESCALATOR	
05	TQ-OPE-MBL-JCDC-01071	CARPARK-ADDITIONAL BEAM REQUIRED FOR ESCALATOR SUPPORT AT L0 LOBBY	
06	TQ-OPE-MBL-JCDC-01108	CARPARK-ADDITIONAL BEAM REQUIRED FOR ESCALATOR SUPPORT AT L0 LOBBY	
07	TQ-OPE-MBL-JCDC-01170	CARPARK-CARPARK SLAB EXTENSION TO SUPPORT ESCALATORS-REVISION OF TQ-01108	
08	RL-OPE-MBL-JCDC-00387	CARPARK-CARPARK SLAB EXTENSION TO SUPPORT ESCALATORS-REVISION OF TQ-01108	
09	TR-OPE-MBL-JCDC-04632-01	MATERIAL SUBMITTAL SAMPLE FOR MR-003: ESCALATOR FINISHES BY OTIS REV.00	
10	ATTACHED	WIRING&CABLE TERM.DIAGRAM(ESCALATOR-1)	
11	ATTACHED	WIRING&CABLE TERM.DIAGRAM(ESCALATOR-2)	
12	JOH-MBL-S5-01-ZZZ-XXX-ZZ-M3-GN-010001	FEDERATED MODEL	
13	JCD-OPE-MBI-MR-003-NMR-601-04	ELEVATORS AND ESCALATORS	
14	SD-OPE-MBL-JCDC-01928	PARKING STRUCTURES PART 002 LEVEL 00 ESCALATOR ADDITIONAL SLAB	

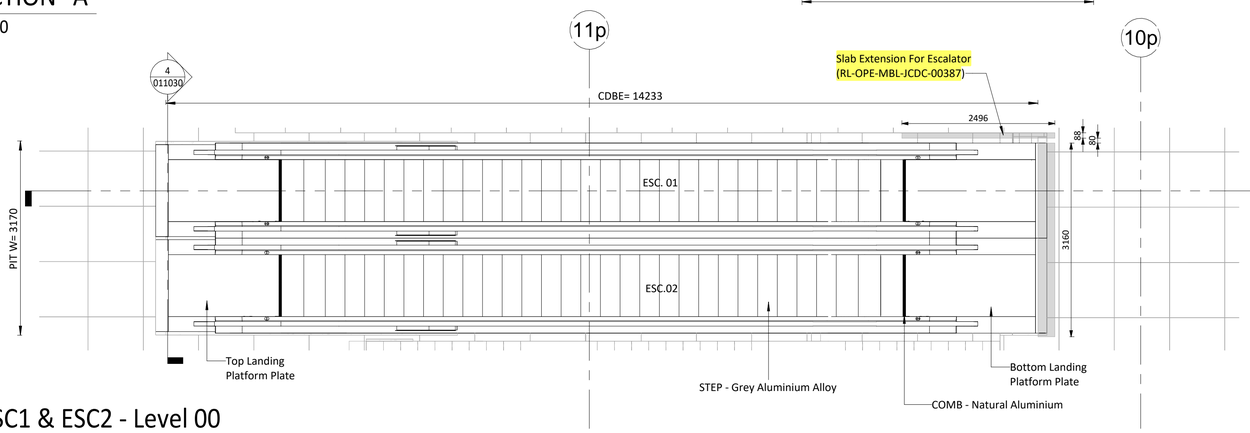

2 ESC1 & ESC2 - Level 00
1 : 50

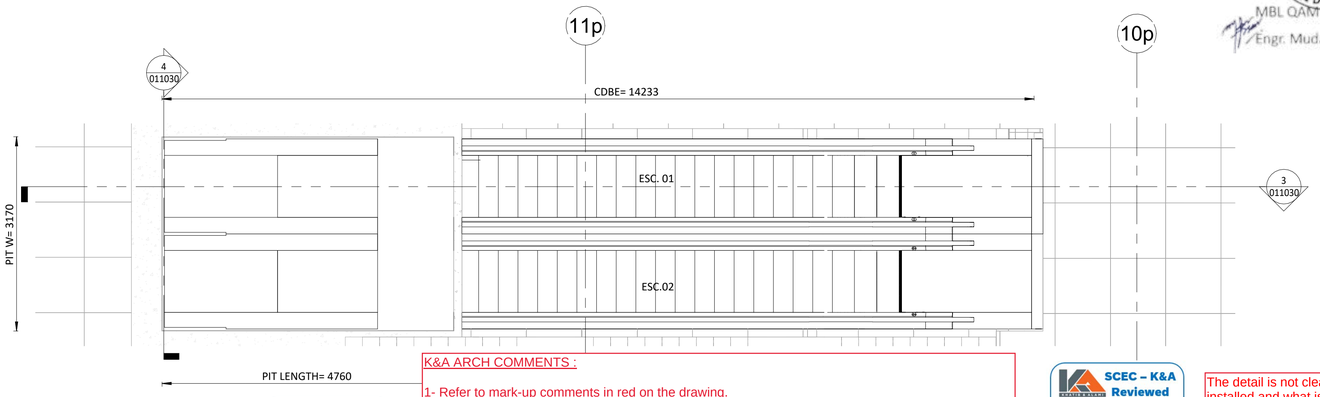

1 ESC1 & ESC2 - Level P1.2
1 : 50




K&A ARCH COMMENTS :

1- Refer to mark-up comments in red on the drawing.
2- As responded in the CRS, Contractor will submit a complete coordinated shop-drawing connection details with floor, ceiling, handrail, and ST cladding installation details and interfaces with adjacent for Architect review and approval.


K&A STRUCTURAL COMMENTS:
- All Levels and Embedded Elements and Pit Dimensions shall be verified prior construction with actual Approved Escalator requirements.
- Comments on relevant Structural SDs shall be fulfilled.
- Comments are shown in red.
- The ceiling structural supports for MEP services below the escalator area to be submitted separately.

Disclaimer: K&A Khatib & Alami – Saudi Consolidated Engineering's review and/or approval does not relieve the Contractor of its obligations under the Contract Documents. The Contractor remains fully responsible for the accuracy, completeness, coordination, and compliance of all submitted documents and executed works. Such review and/or approval shall not constitute acceptance of, or entitlement to, any additional time or cost

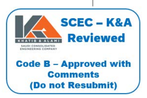






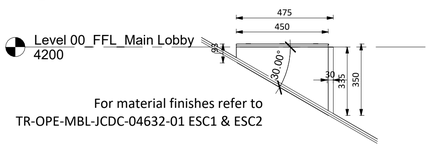

5 UPPER LANDING SUPPORT
1 : 15

What is the material and finish of this plate and angle?

Missing sealant with adjacent floor finish.

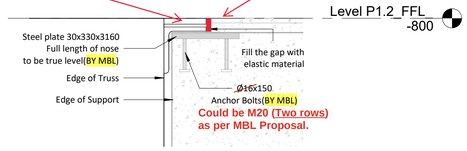

6 LOWER LANDING SUPPORT
1 : 15

7 VERTICAL DEFLECTOR
1 : 15

The detail is not clear; How is this installed and what is the purpose /use?

Reaction(KN/unit)	
Unit 1	Unit 2
A=80	A'=80
B=83	B'=83

Technical parameters		
Unit Number	Unit 1	Unit 2
Contract Number	Unit 1	Unit 2
Product Name	Link	Link
Step Nominal Width(mm)	1000	1000
Speed(m/s)	0.5	0.5
Flat Step Number	2 flat step	2flat step
Rise(mm)	5000	5000
Angle(°)	30	30
Machine Power(each)	7.5KW	7.5KW
Start Current(A)	50.26	50.26
Rated Current(A)	17.5	17.5
Power Votage(V)	380	380
Frequency	60	60
Upper Landing Extension(mm)	700	700
Lower Landing Extension(mm)	100	100

between outer deck; K(K'):Handrail center distance; N(N'):Step width; Q(Q'):Truss width; PITW(PITW'):Pit width

REVIEWED BY DISCIPLINE	SIGNATURE	DATE
ARCHITECTURAL	MT	2026-08-30
STRUCTURAL	PC	2026-08-30
MECHANICAL	Sh.A	2026-08-30
PLUMBING	Sh.A	2026-08-30
ELECTRICAL	Sh.A	2026-08-30
ICT	Sh.A	2026-08-30
ADDITIONAL DISCIPLINES TO BE ADDED AS REQUIRED		

REV	DATE	BY	DESCRIPTION	CHK	APD
S01	27-AUG-2026	Usha	Shop Drawing	Sakr Salma	Ali Basit
S00	22-JUNE-2026	Usha	Issued for Approval	Sakr Salma	Ali Basit

DRAWING STATUS: CONSTRUCTION SHOPDRAWING

CLIENT: شركة وسط جدة للتطوير Jeddah Central Development Co.

LEAD DESIGN CONSULTANTS: Henning Larsen

LEAD ENGINEERING CONSULTANT: BURO HAPPOLD

PROJECT SUPERVISION CONSULTANT: K&A KHATIB & ALAMI

GENERAL CONTRACTOR: MBL

REVIEWER: dar

SUB CONTRACTOR: OTIS ELEVATOR COMPANY SAUDI ARABIA LIMITED

PROJECT: JEDDAH OPERA HOUSE

TITLE: CARPARK BUILDING
VERTICAL TRASNPORTATION
PART 002
PLANS - ELECTRICAL ESCALATORS (ESC 1& ESC2)

SCALE @ A1:	CHECKED:	APPROVED:
As indicated	Sakr Salma	Ali Basit

PROJECT No:	DESIGNED:	DRAWN:	DATE:
440014	Usha	Usha	27-AUG-2026

DRAWING No: JOH-OTS-S5-01-015-002-ZZ-SD-VT-011030 REV: S01

MODEL FILE REF: JOH-OTS-S5-01-015-XXX-ZZ-M3-VT-010001

© JCDC