

Lift 01

fire stop application detail to be submitted separately for review and FLS approval

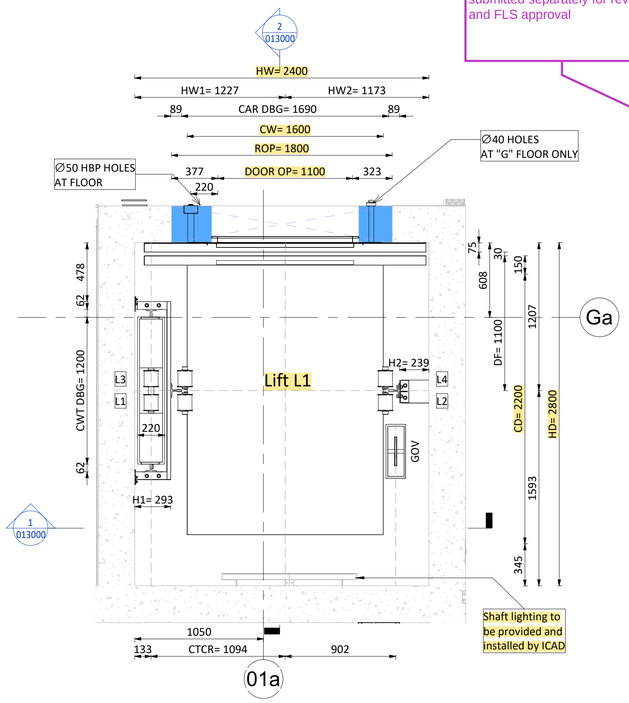

1 Hoist Way Plan At "G" Floor - ELEV-L1


1 : 25

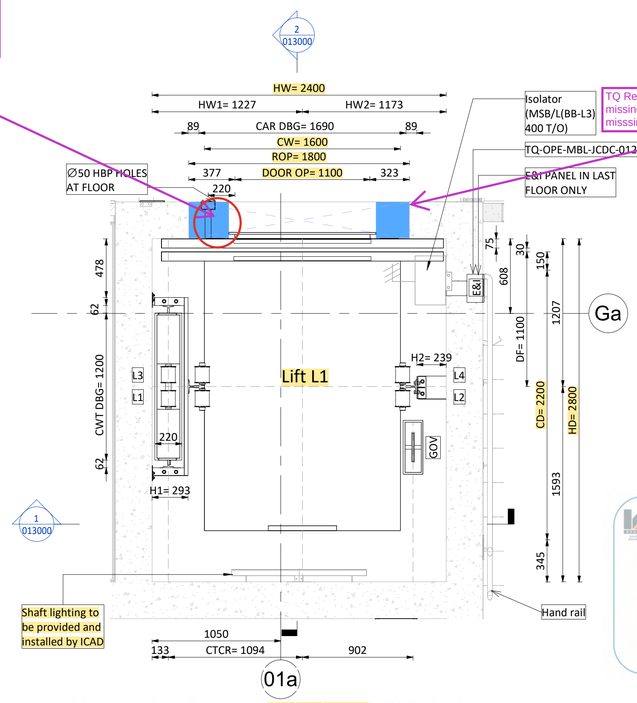

TQ Reference is missing , legend is missing ,


2 Hoist Way Plan At "1" Floor - ELEV-L1

1 : 25

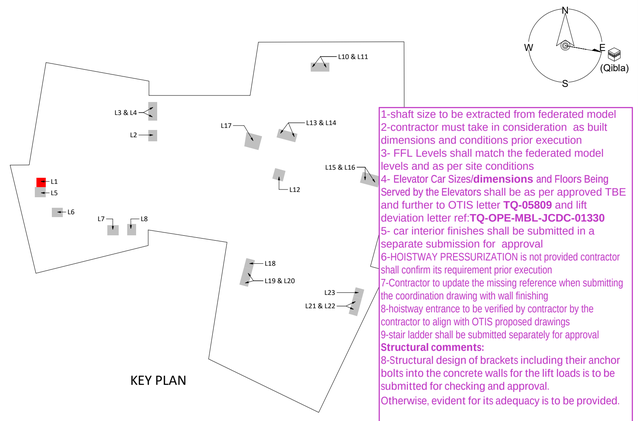

KEY PLAN

1-shaft size to be extracted from federated model
2-contractor must take in consideration as built dimensions and conditions prior execution
3- FFL Levels shall match the federated model levels and as per site conditions
4- Elevator Car Sizes/**dimensions** and Floors Being Served by the Elevators shall be as per approved TBE and further to OTIS letter **TQ-05809** and lift deviation letter ref:**TQ-OPE-MBL-JCDC-01330**
5- car interior finishes shall be submitted in a separate submission for approval
6-HOISTWAY PRESSURIZATION is not provided contractor shall confirm its requirement prior execution
7-Contractor to update the missing reference when submitting the coordination drawing with wall finishing
8-hoistway entrance to be verified by contractor by the contractor to align with OTIS proposed drawings
9-stair ladder shall be submitted separately for approval
Structural comments:
8-Structural design of brackets including their anchor bolts into the concrete walls for the lift loads is to be submitted for checking and approval.
Otherwise, evident for its adequacy is to be provided.

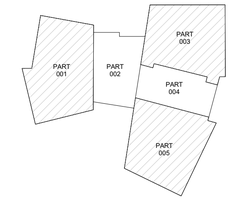


KEY PLAN

GENERAL NOTES: ALL LEVELS SHOWN ON THE DRAWING ARE CHART DATUM LEVELS PROJECT LEVEL+0.000 = +3.700 CHART DATUM.

Refer to :
LIFTS overhead steel hook beams structural calculation and fixation details: TR-OPE-MBL-JCDC-05193-S01
Electrical Panels distribution: JOH-ICD-S5-01-056-XXX-01-SD-EL-011610
wiring diagram opera lift
Acoustic Letter: L-OTIS-MBL-OPE-26-0015

Disclaimer :K&A Khatib Alami – Saudi Consolidated Engineering review and/or approval does not relieve the Contractor from obligation to adhere to Contract Documents. The Contractor remains fully responsible for the accuracy, completeness, coordination, and compliance of all submitted documents and works

SCEC – K&A Reviewed
Civil
Arch.
Elec.
ELV.
Mech.
Acoustic

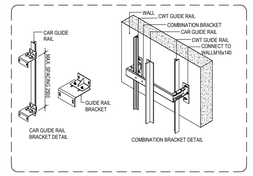

SCEC – K&A Reviewed
Code B – Approved with Comments (Do not Resubmit)


No objection from Electrical side with the following general comments:
1.Contractor to clarify lighting supply requirements and provide locations and provisions for shaft lighting, cabin lighting, emergency lighting, and ventilation fans.
2.Contractor to confirm compatibility with other interfaced systems within the project; BMS, PMS, CCTV, Fire alarm system, Intercom, and cabin speakers as noted on drawings.
3.Contractor to submit wiring diagrams for controller, car operating panel (COP), hall position indicators (HBP), and emergency & inspection panels (E&I).
4.Contractor to clarify the requirements for pit inspection reset switch and fireman service switch installations. (if any Contractor to Provide grounding and earthing details for elevator equipment, guide rails, and machine component.

ELEV-L1 ELEVATOR GEN	
LIFT NUMBER	
CABIN INTERNAL SIZE(WXDXH)	1600X2200X2600
CAPAC	1600 Kg
CLEAR	1100X2400
CONTI	VVVF
CONTI	SIMPLEX DOWN COLLECTIVE
COUN	NO
DOOR TYPE	CLD1
EMERGENCY EXITS	-
FRONT OPENING	2
HEAT RELEASE	1616Kcal/h
HOISTWAY SIZE(HWXHD)	2400X2800
LIFT NUMBER	ELV.L1
LIGHTING SUPPLY	220V 60HZ
MIN.FLOOR HEIGHT	-
NO. OF FLOOR	2
NO. OF OPENINGS	2
NO. OF UNITS	1
NON-STOP FLOORS	-
NON-STOP FLOORS NAMES	-
NUMBER OF PASSENGERS	21P
OVERHEAD	4600mm
PIT DEPTH	1600mm
POWER SUPPLY	380V 3P 60HZ
PRODUCT NO.	GeN2 MRL
RATED CURRENT(A)	25.6
REAR OPENING	-
ROPING	2:1
SPEED(m/s)	1.00
START CURRENT(A)	28.4
SYSTEM POWER(KW)	13.5
TRAVEL	5600 mm
USE	PASSENGER LIFT VIP

add the letter references TQ-05809 & deviation letter

missing information and include only the related TQ

REACTIONS FORCE (KN)			
Car side rail	CWT guide rail	Pit reaction	
R= 41	R= 15	U= 165	
R1= 2.47	R1= 1.13	V= 132	
R2= 3.14	R2= 0.3		

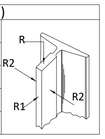

LEGEND	
HW	HOIST WAY WIDTH
HD	HOIST WAY DEPTH
CRH	CAR ROUGH HEIGHT
DOOR OP	DOOR OPENING
ROP	ROUGH OPENING
CW	CAR WIDTH
CD	CAR DEPTH
CH	CAR HEIGHT
DBG	DISTANCE BETWEEN GUARDRAIL
CWT	COUNTERWEIGHT
E&I PANEL	EMERGENCY & INSPECTION PANEL
G.O.V	CAR GOVERNOR
COP	CAR OPERATING PANEL
HBP	HALL POSITION INDICATOR
	CONCRETE
	BLOCK

DRAWING / DOCUMENT REFERENCE

NO.	NUMBER	TITLE	REV.
01	L-01	JOH-HLA-S4-01-056-XXX-01-DR-AR-011110	F00
02		JOH-BHC-S4-01-056-XXX-XX-DR-VT-015001	
03		JOH-BHC-S4-01-056-XXX-XX-DR-VT-010001	
04		JOH-BHC-S4-01-056-005-ZZ-DR-VT-013001	
05		JOH-BHC-S4-01-056-005-ZZ-DR-VT-011001	
06		TQ-OPE-MBL-JCDC-00222	
07		JCD-OPE-MBL-MR-003-NMR-601-03	
08		JCD-OPE-MBL-MR-003-NMR-602-01	
09		TQ-OPE-MBL-JCDC-01299	
10		TR-OPE-MBL-JCDC-05193-01	

REVIEWED BY DISCIPLINE	SIGNATURE	DATE
ARCHITECTURAL		
STRUCTURAL		
MECHANICAL		
PLUMBING		
ELECTRICAL		
ICT		2026-06-07
ADDITIONAL DISCIPLINES TO BE ADDED AS REQUIRED		

REV	DATE	BY	DESCRIPTION	CHK	APD
S00	22-MAY-2026	AK	Issued for Approval	SS	AB

DRAWING STATUS: CONSTRUCTION SHOPDRAWING

CLIENT: شركة جدة للتطوير Jeddah Central Development Co.

LEAD DESIGN CONSULTANTS: Henning Larsen

LEAD ENGINEERING CONSULTANT: BURO HAPPOLD

PROJECT SUPERVISION CONSULTANT: K&A

GENERAL CONTRACTOR: MBL

REVIEWER: dar

SUB CONTRACTOR: OTIS ELEVATOR COMPANY (SAUDI ARABIA) LIMITED — OTIS

PROJECT: JEDDAH OPERA HOUSE

TITLE: OPERA BUILDING
VERTICAL TRANSPORTATION
PART 001
PLANS - LIFT SHAFT (L01)


SCALE @ A1:	CHECKED:	APPROVED:
As indicated	SS	AB

PROJECT No:	DESIGNED:	DRAWN:	DATE:
440014	AK	PR	22-MAY-2026

DRAWING No: JOH-OTS-S5-01-056-001-ZZ-SD-VT-011000 REV: S00


MODEL FILE REF: JOH-OTS-S5-01-056-XXX-ZZ-M3-VT-010001

ⓒ JCDC

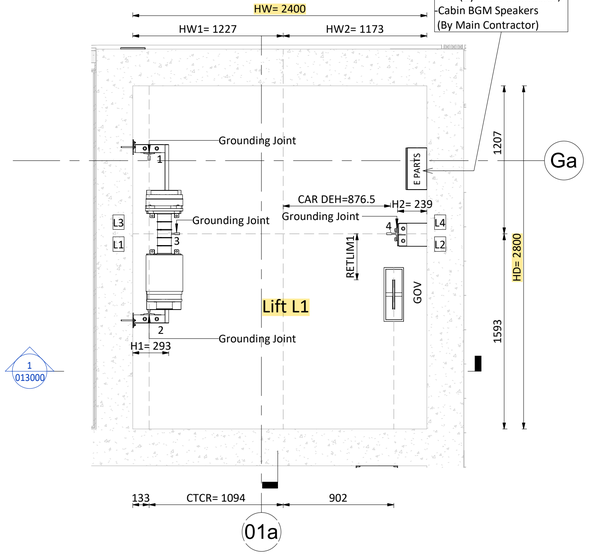


3 Machine Plan Level - ELEV-L1

1 : 25

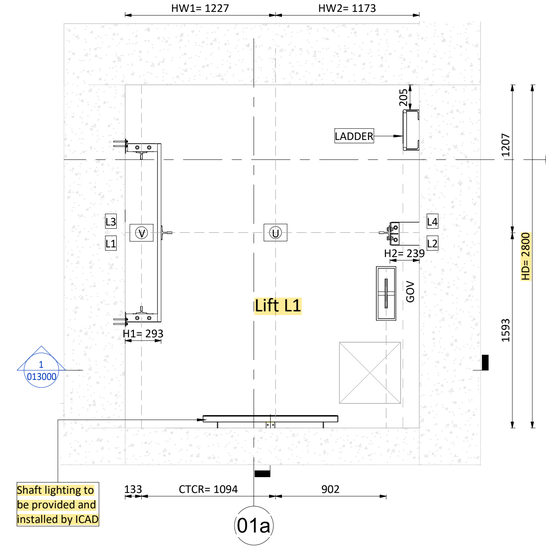

4 Hoist Way Pit Plan - ELEV-L1

1 : 25

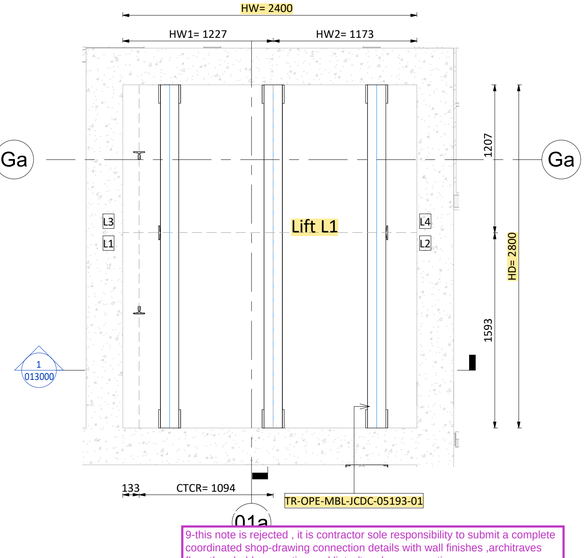

9-this note is rejected , it is contractor sole responsibility to submit a complete coordinated shop-drawing connection details with wall finishes ,architraves floor threshold connection and linter/top door connection

5 Top Hoist Way Hook Plan - ELEV-L1

1 : 25


NOTE No.:
FRONT WALLS FINISHES & ARCHITRAVES TO BE BUILT BY CLIENT) AFTER THE INSTALLATION OF THE (LANDING) EXTERNAL DOORS.

IMPORTANT NOTE FOR MAIN CONTRACTOR.
FREEDOM OF ACCESS MUST BE AVAILABLE FOR POINT OF ENTRY INTO THE BUILDING UP TO THE ELEVATOR HOIST WAY AND THE FRONT WALLS OF THE HOIST WAY AT MAIN FLOOR TO BE LEFT OPEN FOR FULL WIDTH AND HEIGHT TO PERMIT ENTRY OF OUR EQUIPMENT.

MBL to provide a comprehensive Method Statement describing the procedure for filling all gaps and correcting / adjusting the rough openings for doors

Dar Al Handasah (Consultants (Shair and Partners)) Checked and Reviewed Subject to SCEC's Engineer Approval


CONTROLLED COPY MBL IFC JEDDAH OPERA HOUSE PROJECT QA/QC Department MBL QAM Engr. Mudassar Altaf

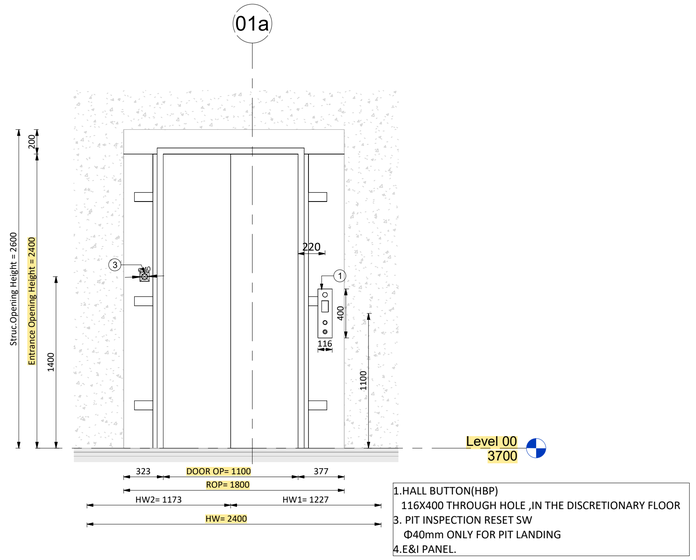

1.HALL BUTTON(HBP)
116X400 THROUGH HOLE ,IN THE DISCRETIONARY FLOOR
3. PIT INSPECTION RESET SW
Φ40mm ONLY FOR PIT LANDING
4.E&I PANEL.


1 Door Elevation At "G" Floor - ELEV-L1

1 : 25

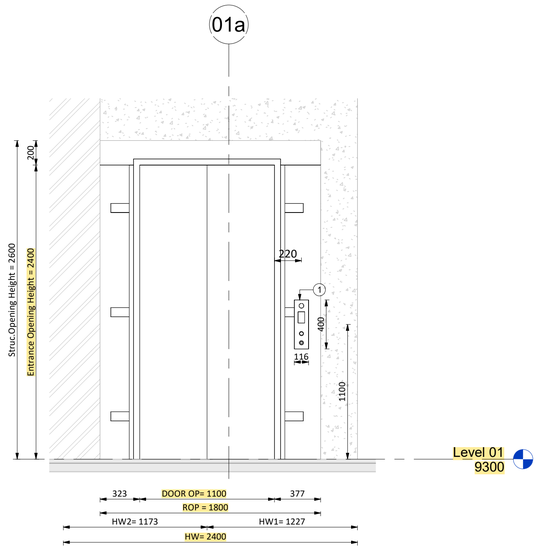


2 Door Elevation At "1" Floor - ELEV-L1

1 : 25

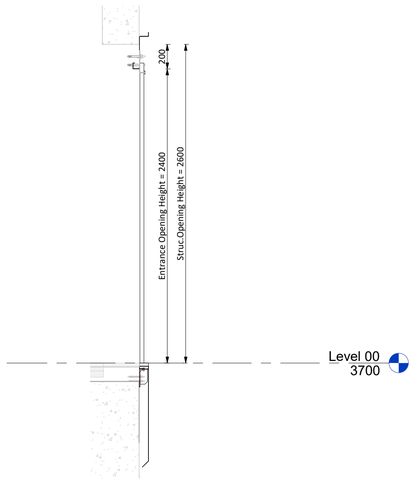


3 Cross-Section View A-A - ELEV-L1

1 : 25

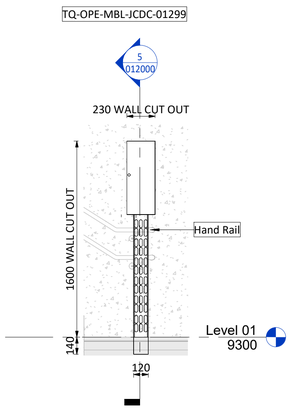


4 E&I SPOT DETAIL - ELEV-L1

1 : 25

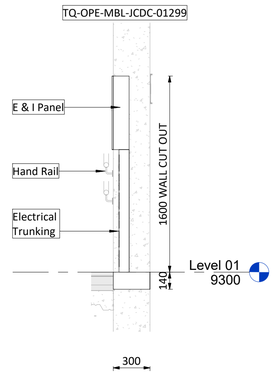

5 Cross-Section View B-B - ELEV-L1

1 : 25

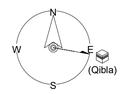


SCEC – K&A Reviewed
Civil
Arch.
Elec.
ELV.
Mech.
Acoustic

SCEC – K&A Reviewed
Code B – Approved with Comments
(Do not Resubmit)

Simplex Units

missing information and include only the related TQ

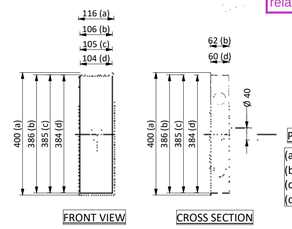

add the letter references TQ-05809 & deviation letter


PUSH BUTTON
(a) FACE PLATE:116(L)x 400 (w)
(b) CONCRETE OPENING: 105 (L) x 386 (w) X 62 (D)
(c) FINISHING OPENING: 105 (L)x 385(w)
(d) Back Box: 104(L) X 384(W) x 60(D)

Disclaimer :K&A Khatib Alami – Saudi Consolidated Engineering review and/or approval does not relieve the Contractor from obligation to adhere to Contract Documents. The Contractor remains fully responsible for the accuracy, completeness, coordination, and compliance of all submitted documents and works

No objection from Electrical side with the following general comments:
1.Contractor to clarify lighting supply requirements and provide locations and provisions for shaft lighting, cabin lighting, emergency lighting, and ventilation fans.
2.Contractor to confirm compatibility with other interfaced systems within the project: BMS, PMS, CCTV, Fire alarm system, Intercom, and cabin speakers as noted on drawings.
3.Contractor to submit wiring diagrams for controller, car operating panel (COP), hall position indicators (HBP), and emergency & inspection panels (E&I).
4.Contractor to clarify the requirements for pit inspection reset switch and fireman service switch installations. (If any Contractor to Provide grounding and earthing details for elevator equipment, guide rails, and machine component.

1-shaft size to be extracted from federated model
2-contractor must take in consideration as built dimensions and conditions prior execution
3- FFL Levels shall match the federated model levels and as per site conditions
4- Elevator Car Sizes/**dimensions** and Floors Being Served by the Elevators shall be as per approved TBE and further to OTIS letter **TQ-05809** and lift deviation letter ref:**TQ-OPE-MBL-JCDC-01330**
5- car interior finishes shall be submitted in a separate submission for approval
6-HOISTWAY PRESSURIZATION is not provided contractor shall confirm its requirement prior execution
7-Contractor to update the missing reference when submitting the coordination drawing with wall finishing
8-hoistway entrance to be verified by contractor by the contractor to align with OTIS proposed drawings
9-stair ladder shall be submitted separately for approval
Structural comments:
8-Structural design of brackets including their anchor bolts into the concrete walls for the lift loads is to be submitted for checking and approval.
Otherwise, evident for its adequacy is to be provided.

CONTROLLED COPY
MBL IFC
JEDDAH OPERA HOUSE PROJECT
QA/QC Department
MBL QAM
Engr. Mudassar Altaf

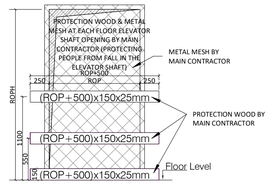


Protection Elevation Detail
At Each Elevator Shaft Opening

MBL to provide a comprehensive Method Statement describing the procedure for filling all gaps and correcting / adjusting the rough openings for doors

dar Dar Al-Handasah consultants (Shair and Partners)
Checked and Reviewed

LEGEND	
HW	HOIST WAY WIDTH
HD	HOIST WAY DEPTH
CRH	CAR ROUGH HEIGHT
DOOR OP	DOOR OPENING
ROP	ROUGH OPENING
CW	CAR WIDTH
CD	CAR DEPTH
CH	CAR HEIGHT
DBG	DISTANCE BETWEEN GUARDRAIL
CWT	COUNTERWEIGHT
E&I PANEL	EMERGENCY & INSPECTION PANEL
G.O.V	CAR GOVERNOR
COP	CAR OPERATING PANEL
HBP	HALL BUTTON POSITION INDICATOR

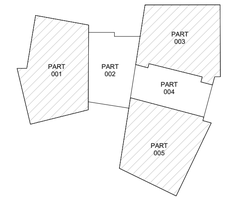

KEY PLAN

GENERAL NOTES: ALL LEVELS SHOWN ON THE DRAWING ARE CHART DATUM LEVELS PROJECT LEVEL+0.000 = +3.700 CHART DATUM.

Refer to :
LIFTS overhead steel hook beams structural calculation and fixation details: TR-OPE-MBL-JCDC-05193-S01
Electrical Panels distribution: JOH-ICD-S5-01-056-XXX-01-SD-EL-011610
wiring diagram opera lift
Acoustic Letter: L-OTIS-MBL-OPE-26-0015

DRAWING / DOCUMENT REFERENCE

NO.	NUMBER	TITLE	REV
01	L-01	JOH-HLA-S4-01-056-XXX-01-DR-AR-011110	F00
02		JOH-BHC-S4-01-056-XXX-XX-DR-VT-015001	
03		JOH-BHC-S4-01-056-XXX-XX-DR-VT-010001	
04		JOH-BHC-S4-01-056-005-ZZ-DR-VT-013001	
05		JOH-BHC-S4-01-056-005-ZZ-DR-VT-011001	
06		TQ-OPE-MBL-JCDC-00222	
07		JCD-OPE-MBL-MR-003-NMR-601-03	
08		JCD-OPE-MBL-MR-003-NMR-602-01	
09		TQ-OPE-MBL-JCDC-01299	
10		TR-OPE-MBL-JCDC-05193-01	

REVIEWED BY DISCIPLINE	SIGNATURE	DATE
ARCHITECTURAL		
STRUCTURAL		
MECHANICAL		
PLUMBING		
ELECTRICAL		
ICT		2026-06-07
ADDITIONAL DISCIPLINES TO BE ADDED AS REQUIRED		

REV	DATE	BY	DESCRIPTION	CHK	APD
S00	22-MAY-2026	AK	Issued for Approval	SS	AB

DRAWING STATUS: CONSTRUCTION SHOPDRAWING

CLIENT: شركة وسط جدة للتطوير Jeddah Central Development Co.

LEAD DESIGN CONSULTANTS: Henning Larsen

LEAD ENGINEERING CONSULTANT: BURO HAPPOLD

PROJECT SUPERVISION CONSULTANT: K&A

GENERAL CONTRACTOR: MBL

REVIEWER: dar

SUB CONTRACTOR: OTIS ELEVATOR COMPANY SAUDI ARABIA LIMITED

PROJECT: JEDDAH OPERA HOUSE

TITLE: OPERA BUILDING
VERTICAL TRANSPORTATION
PART 001
ELEVATIONS - LIFT SHAFT (L01)

SCALE @ A1:	CHECKED:	APPROVED:
As indicated	SS	AB

PROJECT No:	DESIGNED:	DRAWN:	DATE:
440014	AK	PR	22-MAY-2026

DRAWING No: JOH-OTS-S5-01-056-001-ZZ-SD-VT-012000 REV: S00

MODEL FILE REF: JOH-OTS-S5-01-056-XXX-ZZ-M3-VT-010001

© JCDC

CONTROLLED COPY
MBL IFC
JEDDAH OPERA HOUSE PROJECT
QA/QC Department
MBL QAM
Engr. Mudassar Altaf

SCEC – K&A Reviewed
Civil
Arch.
Elec.
ELV.
Mech.
Acoustic


SCEC – K&A Reviewed
Code B – Approved with Comments
(Do not Resubmit)

Disclaimer :K&A Khatib Alami – Saudi Consolidated Engineering review and/or approval does not relieve the Contractor from obligation to adhere to Contract Documents. The Contractor remains fully responsible for the accuracy, completeness, coordination, and compliance of all submitted documents and works

No objection from Electrical side with the following general comments:
1.Contractor to clarify lighting supply requirements and provide locations and provisions for shaft lighting, cabin lighting, emergency lighting, and ventilation fans.
2.Contractor to confirm compatibility with other interfaced systems within the project: BMS, PMS, CCTV, Fire alarm system, Intercom, and cabin speakers as noted on drawings.
3.Contractor to submit wiring diagrams for controller, car operating panel (COP), hall position indicators (HBP), and emergency & inspection panels (E&I).
4.Contractor to clarify the requirements for pit inspection reset switch and fireman service switch installations. (If any Contractor to Provide grounding and earthing details for elevator equipment, guide rails, and machine component.

1-shaft size to be extracted from federated model
2-contractor must take in consideration as built dimensions and conditions prior execution
3- FFL Levels shall match the federated model levels and as per site conditions
4- Elevator Car Sizes/**dimensions** and Floors Being Served by the Elevators shall be as per approved TBE and further to OTIS letter **TQ-05809** and lift deviation letter ref:**TQ-OPE-MBL-JCDC-01330**
5- car interior finishes shall be submitted in a separate submission for approval
6-HOISTWAY PRESSURIZATION is not provided contractor shall confirm its requirement prior execution
7-Contractor to update the missing reference when submitting the coordination drawing with wall finishing
8-hoistway entrance to be verified by contractor by the contractor to align with OTIS proposed drawings
9-stair ladder shall be submitted separately for approval
Structural comments:
8-Structural design of brackets including their anchor bolts into the concrete walls for the lift loads is to be submitted for checking and approval.
Otherwise, evident for its adequacy is to be provided.

N
W
E
S
(Qibla)

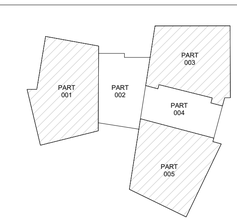

KEY PLAN

GENERAL NOTES: ALL LEVELS SHOWN ON THE DRAWING ARE CHART DATUM LEVELS PROJECT LEVEL+0.000 = +3.700 CHART DATUM.

Refer to :
LIFTS overhead steel hook beams structural calculation and fixation details: TR-OPE-MBL-JCDC-05193-S01
Electrical Panels distribution: JOH-ICD-S5-01-056-XXX-01-SD-EL-011610
wiring diagram opera lift
Acoustic Letter: L-OTIS-MBL-OPE-26-0015

DRAWING / DOCUMENT REFERENCE

NO.	NUMBER	TITLE	REV.
01	L-01	JOH-HLA-S4-01-056-XXX-01-DR-AR-011110	F00
02		JOH-BHC-S4-01-056-XXX-XX-DR-VT-015001	
03		JOH-BHC-S4-01-056-XXX-XX-DR-VT-010001	
04		JOH-BHC-S4-01-056-005-ZZ-DR-VT-013001	
05		JOH-BHC-S4-01-056-005-ZZ-DR-VT-014001	
06		TQ-OPE-MBL-JCDC-00222	
07		JCD-OPE-MBL-MR-003-NMR-601-03	
08		JCD-OPE-MBL-MR-003-NMR-602-01	
09		TQ-OPE-MBL-JCDC-01299	
10		TQ-OPE-MBL-JCDC-00952	

REVIEWED BY DISCIPLINE	SIGNATURE	DATE
ARCHITECTURAL	[illegible]	[illegible]
STRUCTURAL	[illegible]	[illegible]
MECHANICAL	[illegible]	[illegible]
PLUMBING	[illegible]	[illegible]
ELECTRICAL	[illegible]	[illegible]
ICT	[illegible]	2026-06-07
ADDITIONAL DISCIPLINES TO BE ADDED AS REQUIRED		

REV	DATE	BY	DESCRIPTION	CHK	APD
S00	22-MAY-2026	AK	Issued for Approval	SS	AB

DRAWING STATUS: CONSTRUCTION SHOPDRAWING

CLIENT: شركة وسط جدة للتطوير Jeddah Central Development Co.

LEAD DESIGN CONSULTANTS: Henning Larsen
LEAD ENGINEERING CONSULTANT: BURO HAPPOLD
PROJECT SUPERVISION CONSULTANT:
GENERAL CONTRACTOR: MBL
REVIEWER: dar
SUB CONTRACTOR: OTIS ELEVATOR COMPANY SAUDI ARABIA LIMITED

PROJECT: JEDDAH OPERA HOUSE

TITLE: OPERA BUILDING
VERTICAL TRANSPORTATION
PART 001
SECTIONS - LIFT SHAFT (L01)


SCALE @ A1:	CHECKED:	APPROVED:
As indicated	SS	AB

PROJECT No:	DESIGNED:	DRAWN:	DATE:
440014	AK	PR	22-MAY-2026


DRAWING No: JOH-OTS-S5-01-056-001-ZZ-SD-VT-013000
REV: S00

MODEL FILE REF: JOH-OTS-S5-01-056-XXX-ZZ-M3-VT-010001


© JCDC

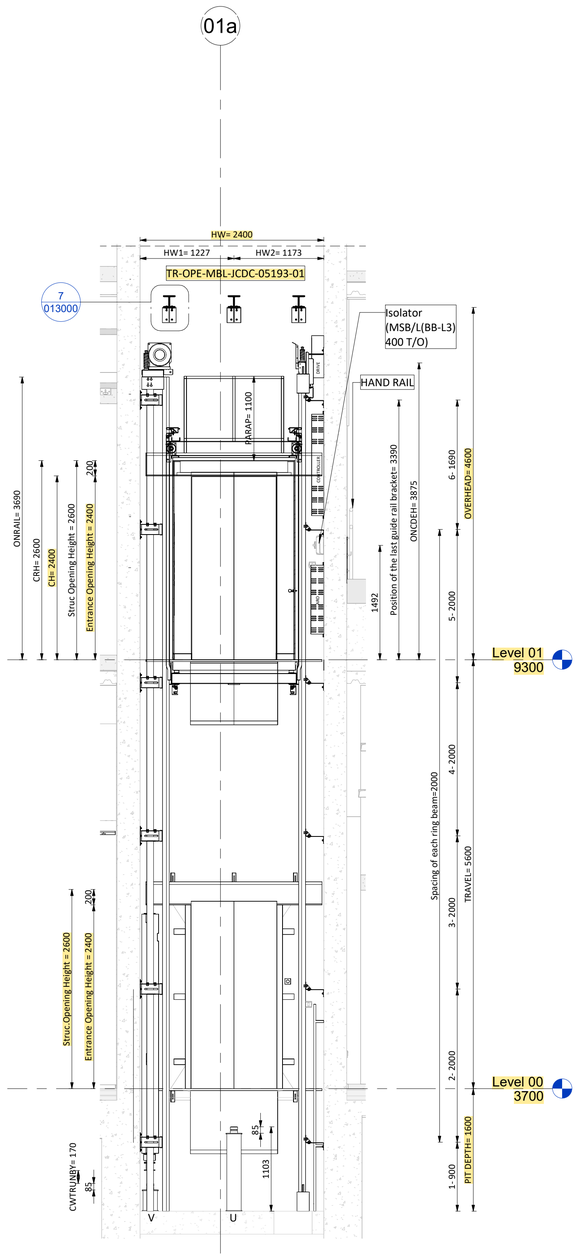


1 Section "A" - ELEV-L1
1 : 40

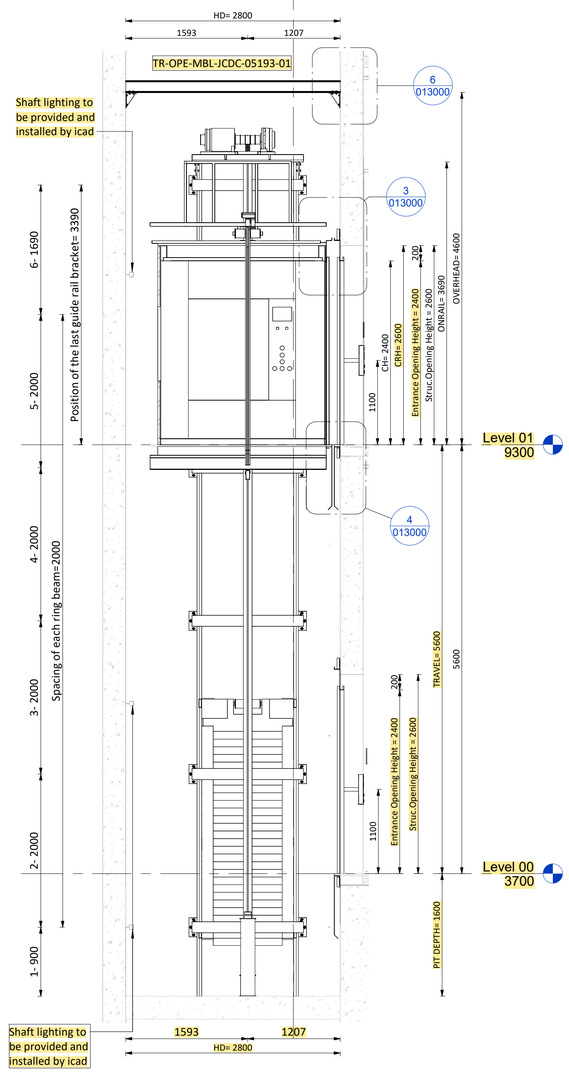


2 Section "B" - ELEV-L1
1 : 40

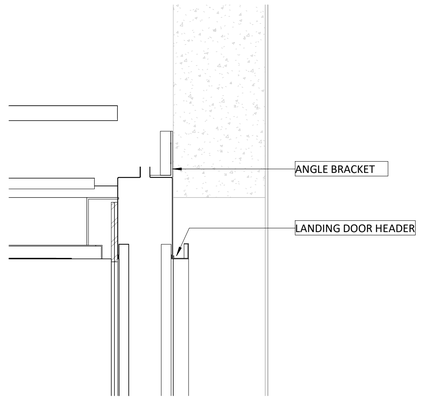

3 Landing Door Header Detail - ELEV -L1
1 : 10

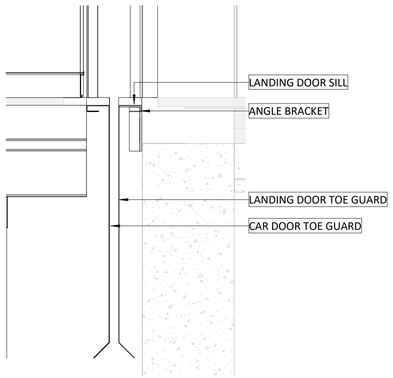


4 Landing Door Bottom Detail - ELEV-L1
1 : 10

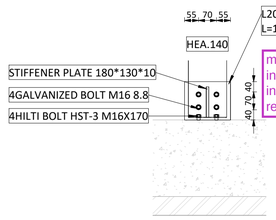


missing information and include only the related TQ

5 DETAIL (A)
1 : 12

add the letter references TQ-05809 & deviation letter

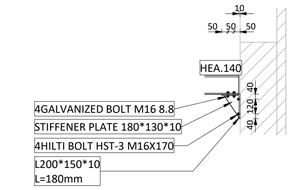

6 DETAIL (A1-A1)
1 : 25

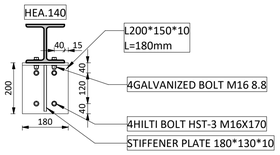

7 DETAIL (B1-B1)
1 : 12

dar Dar Al Handasah consultants (Shair and Partners)
Checked and Reviewed