

Lift 02

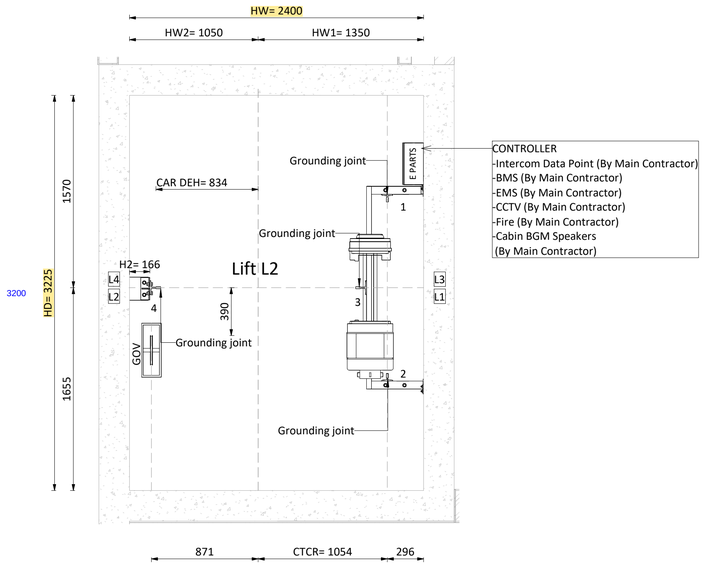


CONTROLLER
-Intercom Data Point (By Main Contractor)
-BMS (By Main Contractor)
-EMS (By Main Contractor)
-CCTV (By Main Contractor)
-Fire (By Main Contractor)
-Cabin BGM Speakers
(By Main Contractor)

1 Machine Plan Level - ELEV-L2
1 : 25

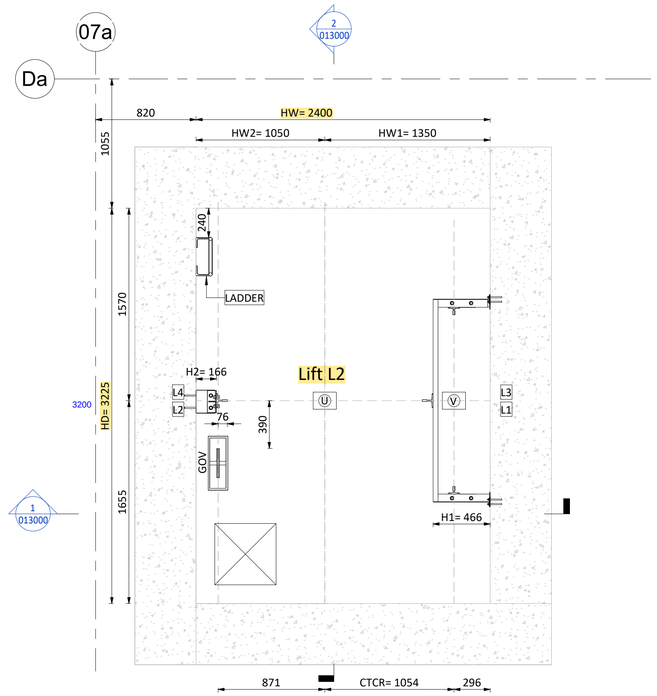

2 Hoist Way Pit Plan - ELEV-L2
1 : 25

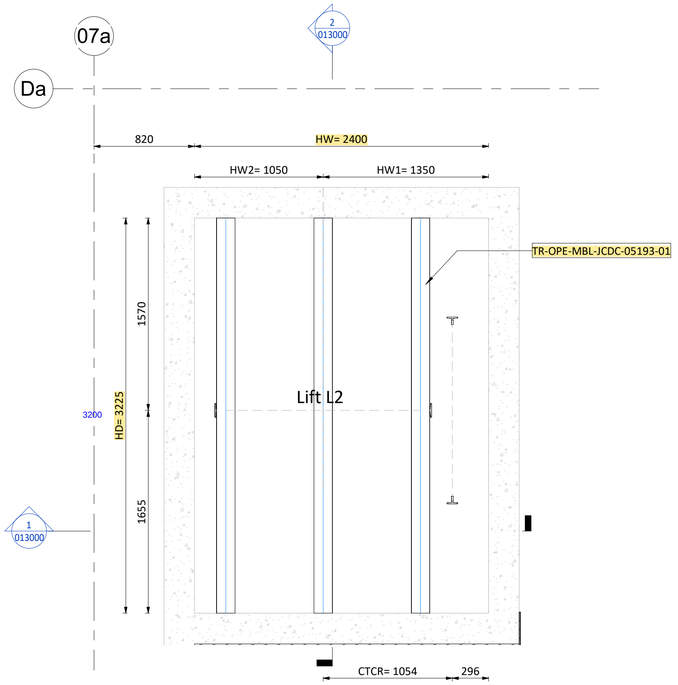


3 Top Hoist Way Hook Plan - ELEV-L2
1 : 25


SCEC – K&A Reviewed

Civil	Arch.	Elec.	ELV.	Mech.	Acoustic
☒	☒	☒	☐	☒	☒



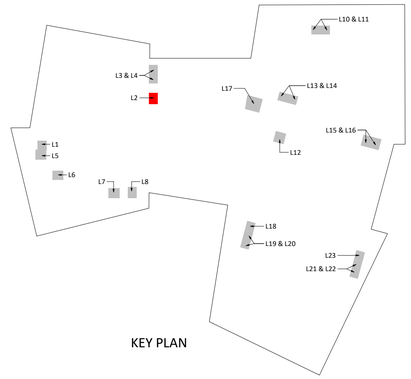

KEY PLAN

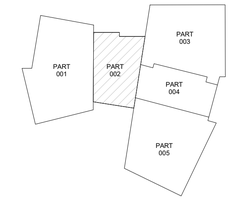

KEY PLAN

GENERAL NOTES: ALL LEVELS SHOWN ON THE DRAWING ARE CHART DATUM LEVELS PROJECT LEVEL+0.000 = +3.700 CHART DATUM.

Refer to :
LIFTS overhead steel hook beams structural calculation and fixation details: TR-OPE-MBL-JCDC-05193-S01
CRS: SD-OPE-MBL-JCDC-01500_L2
Electrical Panels distribution: JOH-ICD-S5-01-056-XXX-03-SD-EL-011630_1
wiring diagram opera lift
Acoustic Letter: L-OTIS-MBL-OPE-26-0015


DRAWING / DOCUMENT REFERENCE

NO.	NUMBER	TITLE	REV.
01	L-02	JOH-HLA-S4-01-056-XXX-01-DR-AR-011110	F00
02		JOH-BHC-S4-01-056-XXX-XX-DR-VT-015001	
03		JOH-BHC-S4-01-056-XXX-XX-DR-VT-010001	
04		JOH-BHC-S4-01-056-005-ZZ-DR-VT-013001	
05		JOH-BHC-S4-01-056-005-ZZ-DR-VT-011001	
06		TQ-OPE-MBL-JCDC-00222	
07		JCD-OPE-MBL-MR-003-NMR-601-03	
08		JCD-OPE-MBL-MR-003-NMR-602-01	
09		TR-OPE-MBL-JCDC-05193-01	

REVIEWED BY DISCIPLINE	SIGNATURE	DATE
ARCHITECTURAL		
STRUCTURAL		
MECHANICAL		
PLUMBING		
ELECTRICAL		
ICT		
ADDITIONAL DISCIPLINES TO BE ADDED AS REQUIRED		

ELEV-L2 ELEVATOR GENERAL SPECIFICATIONS	
LIFT NUMBER	ELEV.L2
CABIN INTERNAL SIZE(WXDXH)	1500X2700X2600
CAPACITY	2000 Kg
CLEAR ENTRANCE doors	1300x2400
CONTROL	VVVF
CONTROL SYSTEM	SIMPLEX FULL COLLECTIVE
COUNTERWEIGHT SAFETY	NO
DOOR TYPE	TLD2
EMERGENCY EXITS	-
FRONT OPENING	4
HEAT RELEASE	1774Kcal/h
HOISTWAY SIZE(HWXHD)	2400X3225 2400*3200
LIFT NUMBER	ELV.L2
LIGHTING SUPPLY	220V 60HZ
MIN.FLOOR HEIGHT	-
NO. OF FLOOR	5
NO. OF OPENINGS	4
NO. OF UNITS	1
NON-STOP FLOORS	1
NON-STOP FLOORS NAMES	B1
NUMBER OF PASSENGERS	26P
OVERHEAD	5400mm
PIT DEPTH	1600mm
POWER SUPPLY	380V 3P 60HZ
PRODUCT NO.	GeN2 MRL
RATED CURRENT(A)	31.4
REAR OPENING	-
ROPING	2:1
SPEED(m/s)	1.00
START CURRENT(A)	34..4
SYSTEM POWER(KW)	16.6
TRAVEL	17325 mm
USE	~~PASSENGER LIFT~~ F&B / Waste


REACTIONS FORCE (KN)			
Car side rail	CWT guide rail	Pit reaction	
R= 91	R= 26	U= 188	
R1= 4.24	R1= 1.76	V= 147	
R2= 2.95	R2= 0.28		

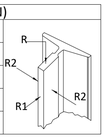

LEGEND	
HW	HOIST WAY WIDTH
HD	HOIST WAY DEPTH
CRH	CAR ROUGH HEIGHT
DOOR OP	DOOR OPENING
ROP	ROUGH OPENING
CW	CAR WIDTH
CD	CAR DEPTH
CH	CAR HEIGHT
DBG	DISTANCE BETWEEN GUARDRAIL
CWT	COUNTERWEIGHT
E&I PANEL	EMERGENCY & INSPECTION PANEL
G.O.V	CAR GOVERNOR
COP	CAR OPERATING PANEL
HBP	HALL POSITION INDICATOR

COMTROLLED COPY
MBL IFC
JEDDAH OPERA HOUSE PROJECT
QA/QC Department
MBL QAM
Engr. Mudassar Altaf

dar Dar Al-Handasah consultants (Shair and Partners)
Checked and Reviewed

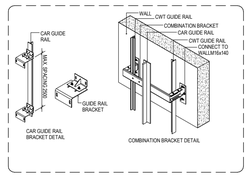

NOTE No.:
FRONT WALLS,FINISHES & ARCHITRAVES TO BE BUILT (BY CLIENT) AFTER THE INSTALLATION OF THE (LANDING) EXTERNAL DOORS.

IMPORTANT NOTE FOR MAIN CONTRACTOR.
FREEDOM OF ACCESS MUST BE AVAILABLE FOR POINT OF ENTRY INTO THE BUILDING UP TO THE ELEVATOR HOIST WAY AND THE FRONT WALLS OF THE HOIST WAY AT MAIN FLOOR TO BE LEFT OPEN FOR FULL WIDTH AND HEIGHT TO PERMIT ENTRY OF OUR EQUIPMENT.

SCEC – K&A Reviewed
Code B – Approved with Comments
(Do not Resubmit)

REV	DATE	BY	DESCRIPTION	CHK	APD
S01	05-MAY-2026	AK	Shop Drawing	SS	AB
S00	05-MAY-2026	AK	Issued for Approval	SS	AB

DRAWING STATUS: CONSTRUCTION SHOPDRAWING

CLIENT: شركة وسط جدة للتطوير Jeddah Central Development Co.

LEAD DESIGN CONSULTANTS: Henning Larsen

LEAD ENGINEERING CONSULTANT: BURO HAPPOLD

PROJECT SUPERVISION CONSULTANT: KHATIB & ALSAMI

GENERAL CONTRACTOR: MBL

REVIEWER: dar

SUB CONTRACTOR: OTIS

PROJECT: JEDDAH OPERA HOUSE

TITLE: OPERA BUILDING
VERTICAL TRANSPORTATION
PART 002
PLANS - LIFT SHAFT 02 OF 02 (L02)


SCALE @ A1:	CHECKED:	APPROVED:
As indicated	SS	AB

PROJECT No:	DESIGNED:	DRAWN:	DATE:
440014	AK	PR	05-MAY-2026

DRAWING No: JOH-OTS-S5-01-056-002-ZZ-SD-VT-011001 REV: S01


MODEL FILE REF: JOH-OTS-S5-01-056-XXX-ZZ-M3-VT-010001

© JCDC

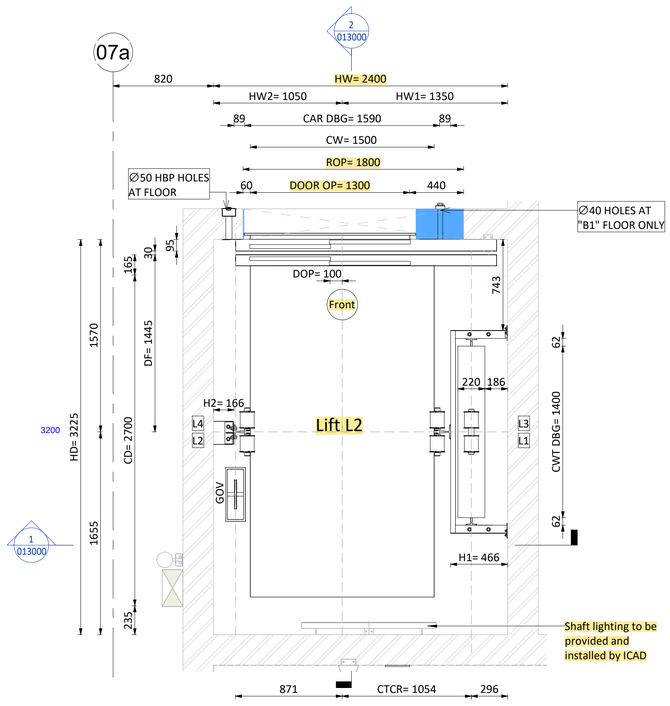


1 Hoist Way Plan At "B2" Floor - ELEV-L2

1 : 25

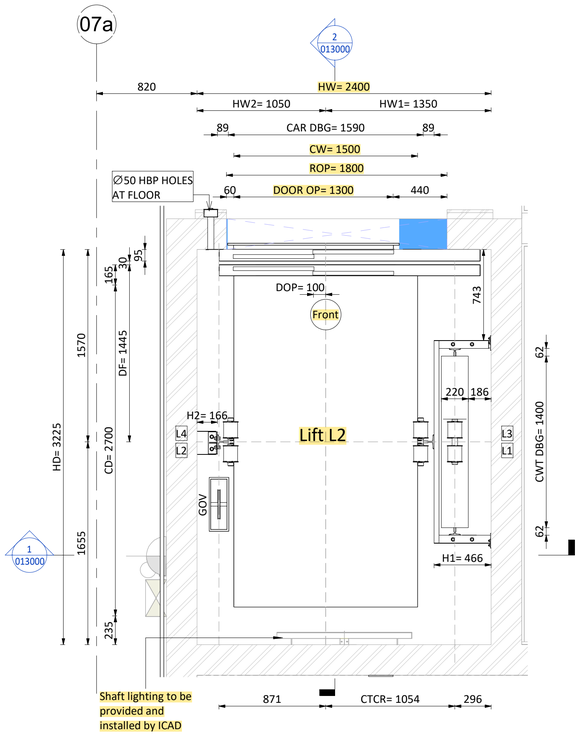

2 Hoist Way Plan At "G & 1" Floor - ELEV-L2

1 : 25

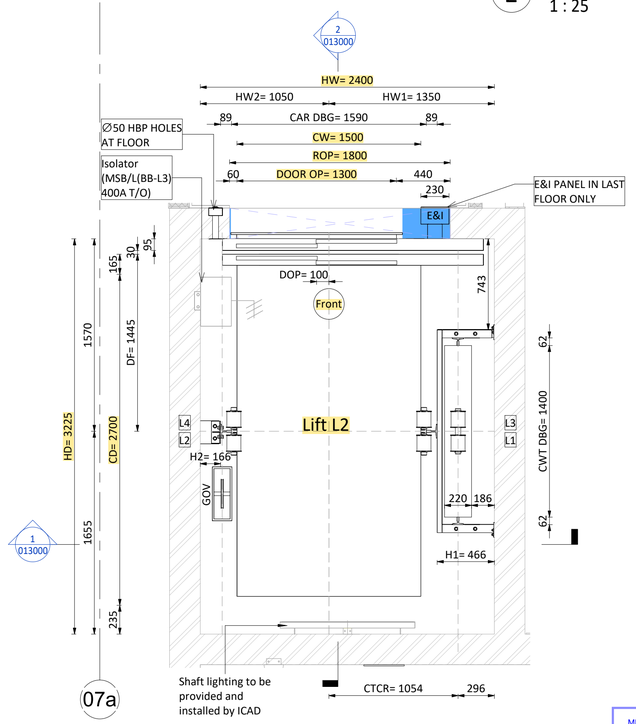

3 Hoist Way Plan At "2" Floor - ELEV-L2

1 : 25

SCEC – K&A Reviewed

Civil	Arch.	Elec.	ELV.	Mech.	Acoustic
☒	☒	☒	☐	☒	☒

SCEC – K&A Reviewed


Code B – Approved with Comments (Do not Resubmit)

MBL to provide a comprehensive Method Statement describing the procedure for filling all gaps and correcting / adjusting the rough openings for doors

dar Dar Al-Handasah consultants (Shair and Partners)


Checked and Reviewed


CONTROLLED COPY
MBL IFC
JEDDAH OPERA HOUSE PROJECT
QA/QC Department
MBL QAM
Engr. Mudassar Altaf

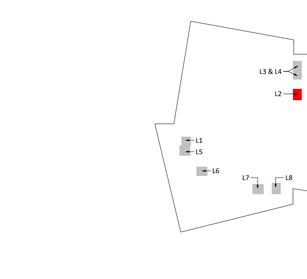

NOTE No.:
FRONT WALLS,FINISHES & ARCHITRAVES TO BE BUILT (BY CLIENT) AFTER THE INSTALLATION OF THE (LANDING) EXTERNAL DOORS.

IMPORTANT NOTE FOR MAIN CONTRACTOR.
FREEDOM OF ACCESS MUST BE AVAILABLE FOR POINT OF ENTRY INTO THE BUILDING UP TO THE ELEVATOR HOIST WAY AND THE FRONT WALLS OF THE HOIST WAY AT MAIN FLOOR TO BE LEFT OPEN FOR FULL WIDTH AND HEIGHT TO PERMIT ENTRY OF OUR EQUIPMENT.

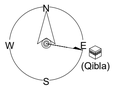

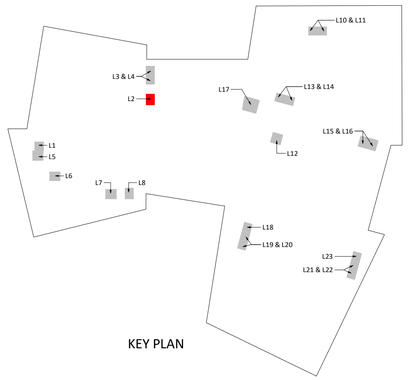


KEY PLAN

ELEV-L2 ELEVATOR GENERAL SPECIFICATIONS	
LIFT NUMBER	ELEV.L2
CABIN INTERNAL SIZE(WXDXH)	1500X2700X2600
CAPACITY	2000 Kg
CLEAR ENTRANCE	1300x2400
CONTROL	VVVF
CONTROL SYSTEM	SIMPLEX FULL COLLECTIVE
COUNTERWEIGHT SAFETY	NO
DOOR TYPE	TLD2
EMERGENCY EXITS	-
FRONT OPENING	4
HEAT RELEASE	1774Kcal/h
HOISTWAY SIZE(HWXHD)	2400X3225
LIFT NUMBER	ELV.L2
LIGHTING SUPPLY	220V 60HZ
MIN.FLOOR HEIGHT	-
NO. OF FLOOR	5
NO. OF OPENINGS	4
NO. OF UNITS	1
NON-STOP FLOORS	1
NON-STOP FLOORS NAMES	B1
NUMBER OF PASSENGERS	26P
OVERHEAD	5400mm
PIT DEPTH	1600mm
POWER SUPPLY	380V 3P 60HZ
PRODUCT NO.	GeN2 MRL
RATED CURRENT(A)	31.4
REAR OPENING	-
ROPING	2:1
SPEED(m/s)	1.00
START CURRENT(A)	34..4
SYSTEM POWER(KW)	16.6
TRAVEL	17325 mm
USE	~~PASSENGER LIFT~~ F&B / Waste

REACTIONS FORCE (KN)			
Car side rail	CWT guide rail	Pit reaction	
R= 91	R= 26	U= 188	R, R2, R1, R2
R1= 4.24	R1= 1.76	V= 147	
R2= 2.95	R2= 0.28		

LEGEND	
HW	HOIST WAY WIDTH
HD	HOIST WAY DEPTH
CRH	CAR ROUGH HEIGHT
DOOR OP	DOOR OPENING
ROP	ROUGH OPENING
CW	CAR WIDTH
CD	CAR DEPTH
CH	CAR HEIGHT
DBG	DISTANCE BETWEEN GUARDRAIL
CWT	COUNTERWEIGHT
E&I PANEL	EMERGENCY & INSPECTION PANEL
G.O.V	CAR GOVERNOR
COP	CAR OPERATING PANEL
HBP	HALL POSITION INDICATOR

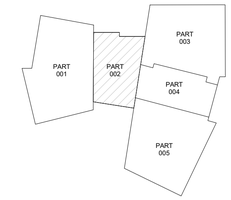

KEY PLAN

GENERAL NOTES: ALL LEVELS SHOWN ON THE DRAWING ARE CHART DATUM LEVELS PROJECT LEVEL+0.000 = +3.700 CHART DATUM.

Refer to :
LIFTS overhead steel hook beams structural calculation and fixation details: TR-OPE-MBL-JCDC-05193-S01
CRS: SD-OPE-MBL-JCDC-01500_L2
Electrical Panels distribution: JOH-ICD-S5-01-056-XXX-03-SD-EL-011630_1
wiring diagram opera lift
Acoustic Letter: L-OTIS-MBL-OPE-26-0015

DRAWING / DOCUMENT REFERENCE

NO.	NUMBER	TITLE	REV.
01	L-02	JOH-HLA-S4-01-056-XXX-01-DR-AR-011110	F00
02		JOH-BHC-S4-01-056-XXX-XX-DR-VT-015001	
03		JOH-BHC-S4-01-056-XXX-XX-DR-VT-010001	
04		JOH-BHC-S4-01-056-005-ZZ-DR-VT-013001	
05		JOH-BHC-S4-01-056-005-ZZ-DR-VT-011001	
06		TQ-OPE-MBL-JCDC-00222	
07		JCD-OPE-MBL-MR-003-NMR-601-03	
08		JCD-OPE-MBL-MR-003-NMR-602-01	
09		TR-OPE-MBL-JCDC-05193-01	

REVIEWED BY DISCIPLINE	SIGNATURE	DATE
ARCHITECTURAL		
STRUCTURAL		
MECHANICAL		
PLUMBING		
ELECTRICAL		
ICT		
ADDITIONAL DISCIPLINES TO BE ADDED AS REQUIRED		

REV	DATE	BY	DESCRIPTION	CHK	APD
S01	05-MAY-2026	AK	Shop Drawing	SS	AB
S00	05-MAY-2026	AK	Issued for Approval	SS	AB

DRAWING STATUS: CONSTRUCTION SHOPDRAWING

CLIENT: شركة وسط جدة للتطوير Jeddah Central Development Co.

LEAD DESIGN CONSULTANTS: Henning Larsen

LEAD ENGINEERING CONSULTANT: BURO HAPPOLD

PROJECT SUPERVISION CONSULTANT: SAUDI CONSOLIDATED ENGINEERING COMPANY

GENERAL CONTRACTOR: MBL

REVIEWER: dar

SUB CONTRACTOR: OTIS

PROJECT: JEDDAH OPERA HOUSE

TITLE: OPERA BUILDING
VERTICAL TRANSPORTATION
PART 002
PLANS - LIFT SHAFT 01 OF 02 (L02)


SCALE @ A1:	CHECKED:	APPROVED:
1:25	SS	AB

PROJECT No:	DESIGNED:	DRAWN:	DATE:
440014	Abdul Kafoor	Pranoti	05-MAY-2026


DRAWING No: JOH-OTS-S5-01-056-002-ZZ-SD-VT-011000 REV: S01


MODEL FILE REF: JOH-OTS-S5-01-056-XXX-ZZ-M3-VT-010001

© JCDC

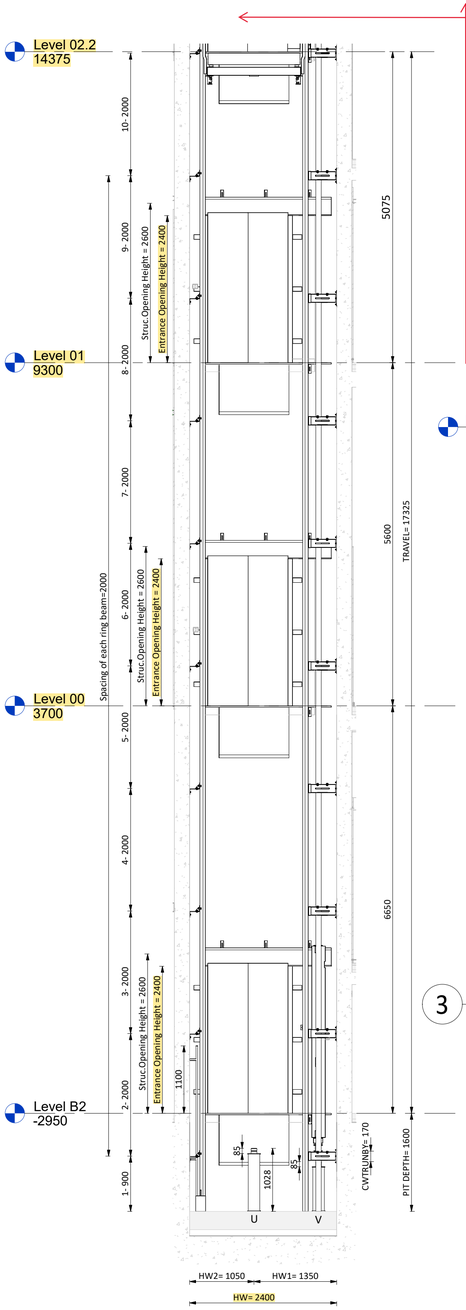


1 Section "A" - ELEV-L2
1 : 50

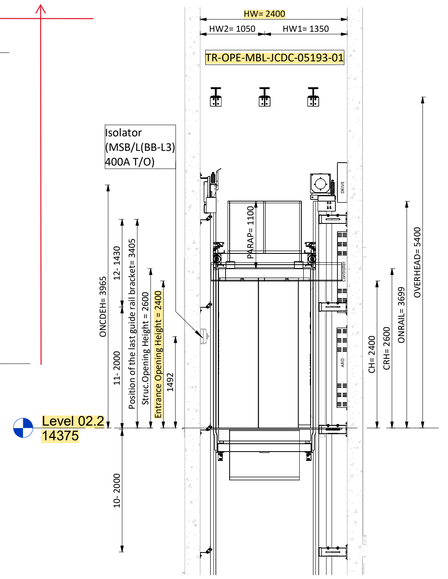


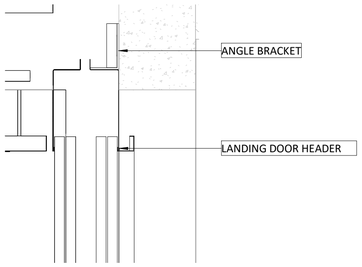


3 Landing Door Header Detail - ELEV-L2
1 : 10

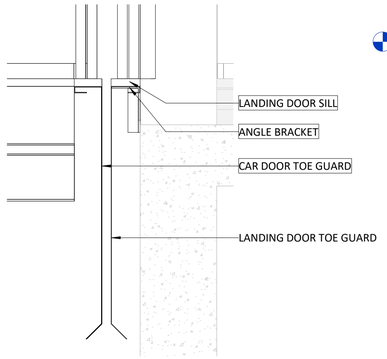


4 Landing Door Bottom Detail - ELEV-L2
1 : 10

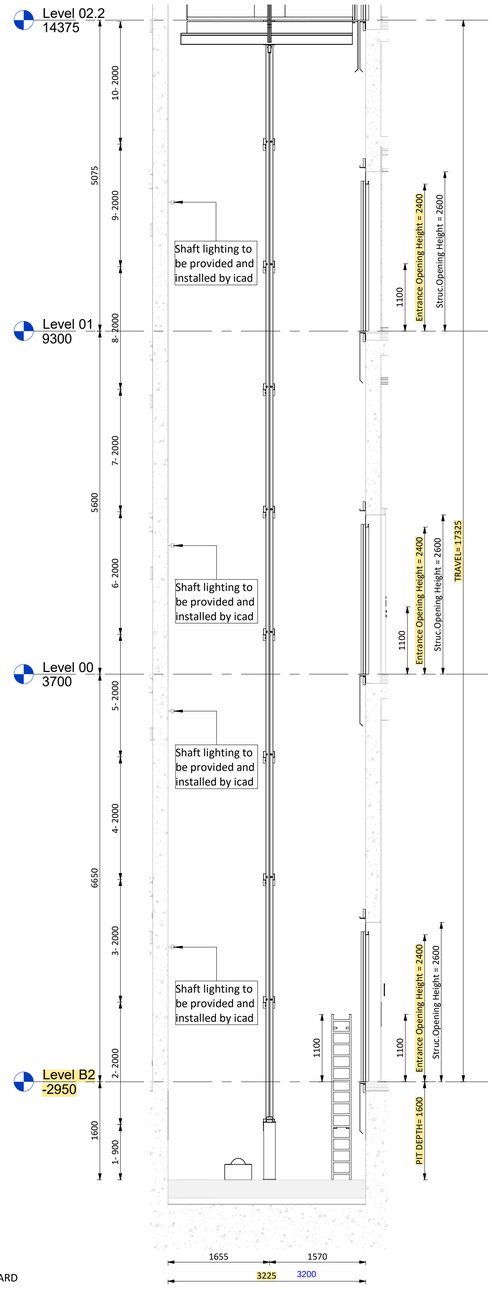


2 Section "B" - ELEV-
1 : 50

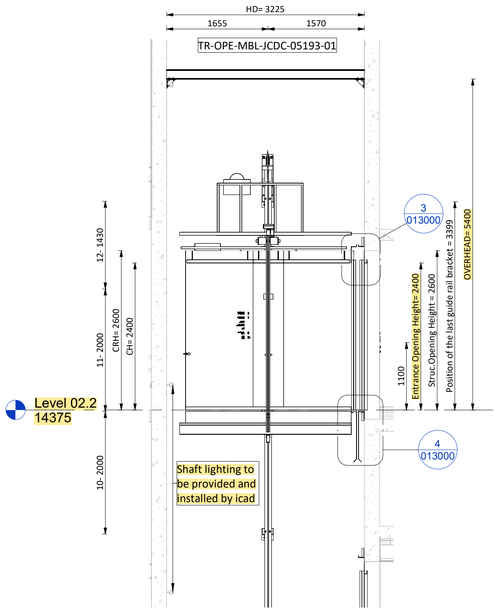


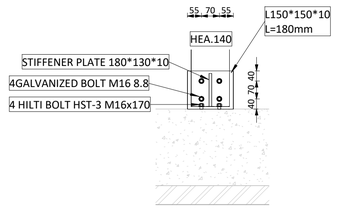


6 DETAIL (A)
1 : 12

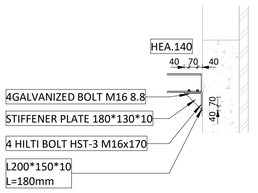


7 DETAIL (A1-A1)
1 : 25

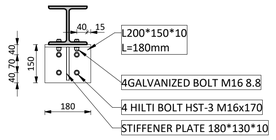

8 DETAIL (B1-B1)
1 : 12

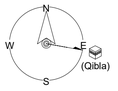

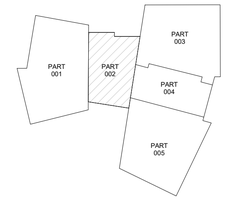

KEY PLAN

GENERAL NOTES: ALL LEVELS SHOWN ON THE DRAWING ARE CHART DATUM LEVELS PROJECT LEVEL+0.000 = +3.700 CHART DATUM.

Refer to :
LIFTS overhead steel hook beams structural calculation and fixation details: TR-OPE-MBL-JCDC-05193-S01
CRS: SD-OPE-MBL-JCDC-01500_L2
Electrical Panels distribution: JOH-ICD-S5-01-056-XXX-03-SD-EL-011630_1
wiring diagram opera lift
Acoustic Letter: L-OTIS-MBL-OPE-26-0015

DRAWING / DOCUMENT REFERENCE

NO.	NUMBER	TITLE	REV.
01	L-02	JOH-HLA-S4-01-056-XXX-01-DR-AR-011110	F00
02		JOH-BHC-S4-01-056-XXX-XX-DR-VT-015001	
03		JOH-BHC-S4-01-056-XXX-XX-DR-VT-010001	
04		JOH-BHC-S4-01-056-005-ZZ-DR-VT-013001	
05		JOH-BHC-S4-01-056-005-ZZ-DR-VT-011001	
06		TQ-OPE-MBL-JCDC-00222	
07		JCD-OPE-MBL-MR-003-NMR-601-03	
08		JCD-OPE-MBL-MR-003-NMR-602-01	
09		TR-OPE-MBL-JCDC-05193-01	

REVIEWED BY DISCIPLINE	SIGNATURE	DATE
ARCHITECTURAL	[illegible]	[illegible]
STRUCTURAL	[illegible]	[illegible]
MECHANICAL	[illegible]	[illegible]
PLUMBING	[illegible]	[illegible]
ELECTRICAL	[illegible]	[illegible]
ICT	[illegible]	[illegible]
ADDITIONAL DISCIPLINES TO BE ADDED AS REQUIRED		

REV	DATE	BY	DESCRIPTION	CHK	APD
S01	05-MAY-2026	AK	Shop Drawing	SS	AB
S00	05-MAY-2026	AK	Issued for Approval	SS	AB

DRAWING STATUS: CONSTRUCTION SHOPDRAWING

CLIENT: شركة وسط جدة للتطوير Jeddah Central Development Co.

LEAD DESIGN CONSULTANTS: Henning Larsen

LEAD ENGINEERING CONSULTANT: BURO HAPPOLD

PROJECT SUPERVISION CONSULTANT: KHATIB & ALAMI

GENERAL CONTRACTOR: MBL

REVIEWER: dar

SUB CONTRACTOR: OTIS ELEVATOR COMPANY (SAUDI ARABIA) LIMITED — OTIS

PROJECT: JEDDAH OPERA HOUSE

TITLE: OPERA BUILDING
VERTICAL TRANSPORTATION
PART 002
SECTIONS - LIFT SHAFT (L02)

SCALE @ A1:	CHECKED:	APPROVED:
As indicated	SS	AB

PROJECT No:	DESIGNED:	DRAWN:	DATE:
440014	AK	PR	05-MAY-2026

DRAWING No: JOH-OTS-S5-01-056-002-ZZ-SD-VT-013000 REV: S01

MODEL FILE REF: JOH-OTS-S5-01-056-XXX-ZZ-M3-VT-010001


© JCDC

SCEC – K&A Reviewed
Civil Arch. Elec. ELV. Mech. Acoustic

CONTROLLED COPY MBL IFC JEDDAH OPERA HOUSE PROJECT QA/QC Department
MBL QAM
Engr. Mudassar Altaf

SCEC – K&A Reviewed
Code B – Approved with Comments
(Do not Resubmit)

dar Dar Al-Handasah consultants (Shair and Partners)
Checked and Reviewed
Subject to SCEC's Engineer Approval

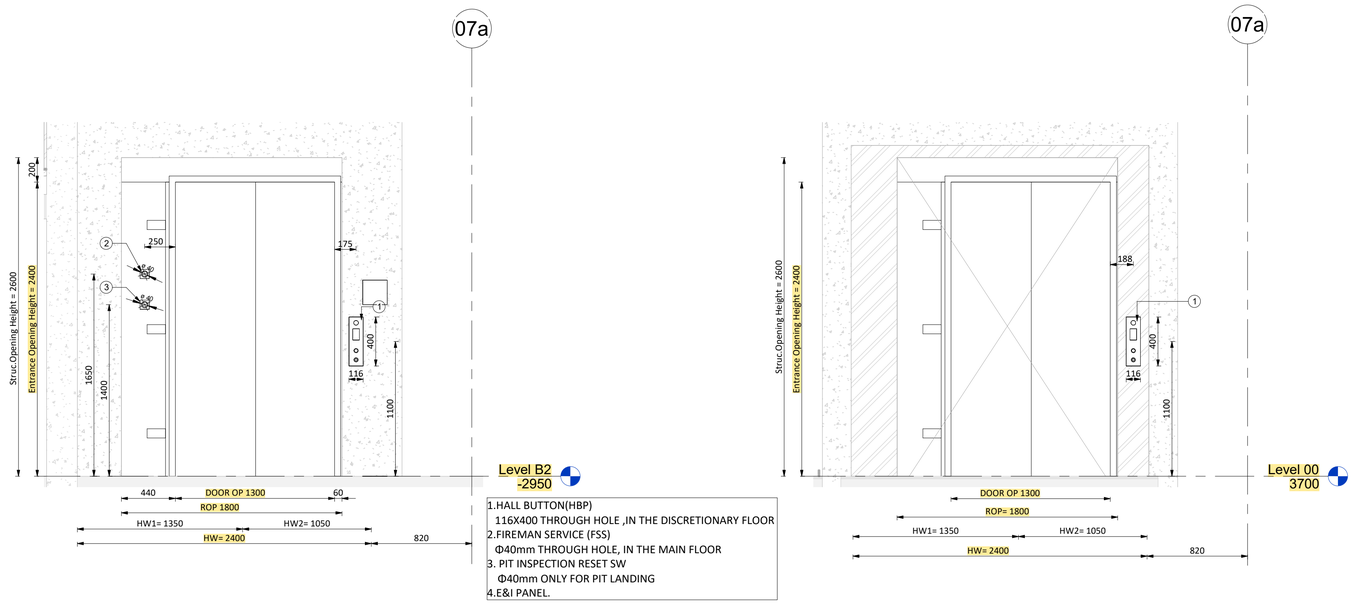


1.HALL BUTTON(HBP)
116X400 THROUGH HOLE ,IN THE DISCRETIONARY FLOOR
2.FIREMAN SERVICE (FSS)
Φ40mm THROUGH HOLE, IN THE MAIN FLOOR
3. PIT INSPECTION RESET SW
Φ40mm ONLY FOR PIT LANDING
4.E&I PANEL.

1 Door Elevation At "B2" Floor (FRONT) - ELEV-L2

1 : 25


2 Door Elevation At "G1 & 1" Floor (FRONT) - ELEV-L2

1 : 25

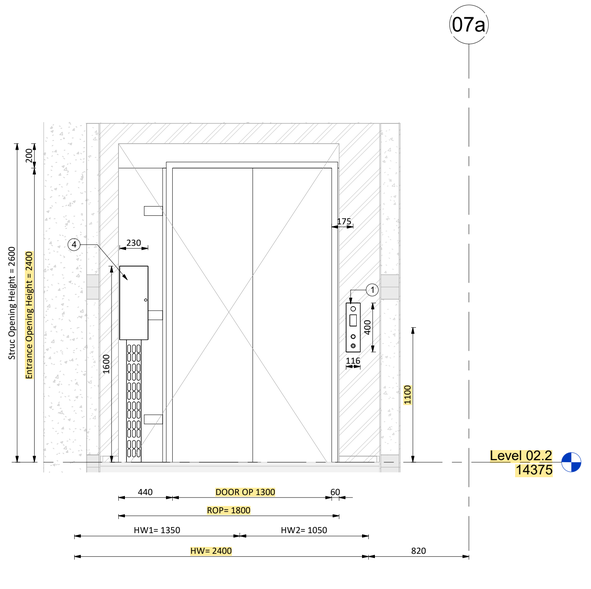


3 Door Elevation At "2" Floor (FRONT) - ELEV-L2

1 : 25

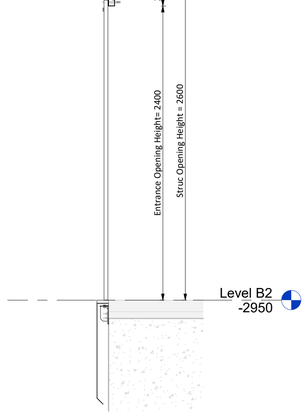


4 Door Section-B-B - ELEV-L2

1 : 25

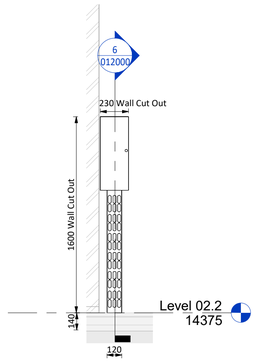


5 E&I SPOT DETAIL - ELEV-L2


1 : 25

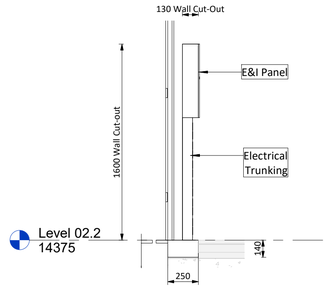

6 Cross-Section View A-A - ELEV-L2

1 : 25

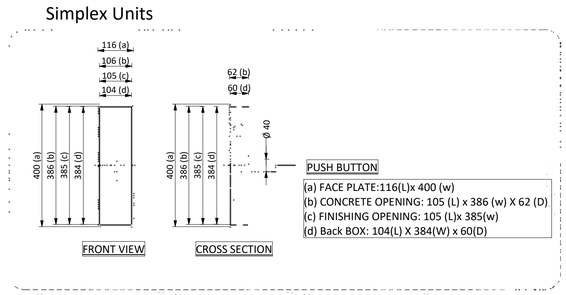

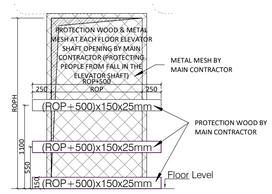

Protection Elevation Detail
At Each Elevator Shaft Opening

CONTROLLED COPY
MBL IFC
JEDDAH OPERA HOUSE PROJECT
QA/QC Department
MBL QAM
Engr. Mudassar Altaf


SCEC – K&A Reviewed

	Civil	Arch.	Elec.	ELV.	Mech.	Acoustic
	☒	☒	☒	☐	☒	☒

SCEC – K&A Reviewed
Code B – Approved with Comments
(Do not Resubmit)

dar Dar Al-Handasah consultants (Shair and Partners)
Checked and Reviewed
MBL to provide a comprehensive Method Statement describing the procedure for filling all gaps and correcting / adjusting the rough openings for doors

LEGEND	
HW	HOIST WAY WIDTH
HD	HOIST WAY DEPTH
CRH	CAR ROUGH HEIGHT
DOOR OP	DOOR OPENING
ROP	ROUGH OPENING
CW	CAR WIDTH
CD	CAR DEPTH
CH	CAR HEIGHT
DBG	DISTANCE BETWEEN GUARDRAIL
CWT	COUNTERWEIGHT
E&I PANEL	EMERGENCY & INSPECTION PANEL
G.O.V	CAR GOVERNOR
COP	CAR OPERATING PANEL
HBP	HALL POSITION INDICATOR

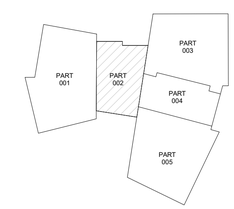

KEY PLAN

GENERAL NOTES: ALL LEVELS SHOWN ON THE DRAWING ARE CHART DATUM LEVELS PROJECT LEVEL+0.000 = +3.700 CHART DATUM.

Refer to :
LIFTS overhead steel hook beams structural calculation and fixation details: TR-OPE-MBL-JCDC-05193-S01
CRS: SD-OPE-MBL-JCDC-01500_L2
Electrical Panels distribution: JOH-ICD-S5-01-056-XXX-03-SD-EL-011630_1
wiring diagram opera lift
Acoustic Letter: L-OTIS-MBL-OPE-26-0015

DRAWING / DOCUMENT REFERENCE

NO.	NUMBER	TITLE	REV.
01	L-02	JOH-HLA-S4-01-056-XXX-01-DR-AR-011110	F00
02		JOH-BHC-S4-01-056-XXX-XX-DR-VT-015001	
03		JOH-BHC-S4-01-056-XXX-XX-DR-VT-010001	
04		JOH-BHC-S4-01-056-005-ZZ-DR-VT-013001	
05		JOH-BHC-S4-01-056-005-ZZ-DR-VT-011001	
06		TQ-OPE-MBL-JCDC-00222	
07		JCD-OPE-MBL-MR-003-NMR-601-03	
08		JCD-OPE-MBL-MR-003-NMR-602-01	
09		TR-OPE-MBL-JCDC-05193-01	

REVIEWED BY DISCIPLINE	SIGNATURE	DATE
ARCHITECTURAL	[illegible]	[illegible]
STRUCTURAL	[illegible]	[illegible]
MECHANICAL	[illegible]	[illegible]
PLUMBING	[illegible]	[illegible]
ELECTRICAL	[illegible]	[illegible]
ICT	[illegible]	[illegible]
ADDITIONAL DISCIPLINES TO BE ADDED AS REQUIRED		

REV	DATE	BY	DESCRIPTION	CHK	APD
S01	05-MAY-2026	AK	Shop Drawing	SS	AB
S00	05-MAY-2026	AK	Issued for Approval	SS	AB

DRAWING STATUS: CONSTRUCTION SHOPDRAWING

CLIENT: شركة جدة للتطوير Jeddah Central Development Co.

LEAD DESIGN CONSULTANTS: Henning Larsen

LEAD ENGINEERING CONSULTANT: BURO HAPPOLD

PROJECT SUPERVISION CONSULTANT: K&A

GENERAL CONTRACTOR: MBL

REVIEWER: dar

SUB CONTRACTOR: OTIS ELEVATOR COMPANY (SAUDI ARABIA) LIMITED

PROJECT: JEDDAH OPERA HOUSE

TITLE: OPERA BUILDING
VERTICAL TRANSPORTATION
PART 002
ELEVATIONS - LIFT SHAFT (L02)

SCALE @ A1:	CHECKED:	APPROVED:	
As indicated	SS	AB	
PROJECT No:	DESIGNED:	DRAWN:	DATE:
440014	AK	PR	05-MAY-2026

DRAWING No: JOH-OTS-S5-01-056-002-ZZ-SD-VT-012000 REV: S01

MODEL FILE REF: JOH-OTS-S5-01-056-XXX-ZZ-M3-VT-010001

© JCDC