


Lift 03,04

fire stop application detail to be submitted separately for review and FLS approval

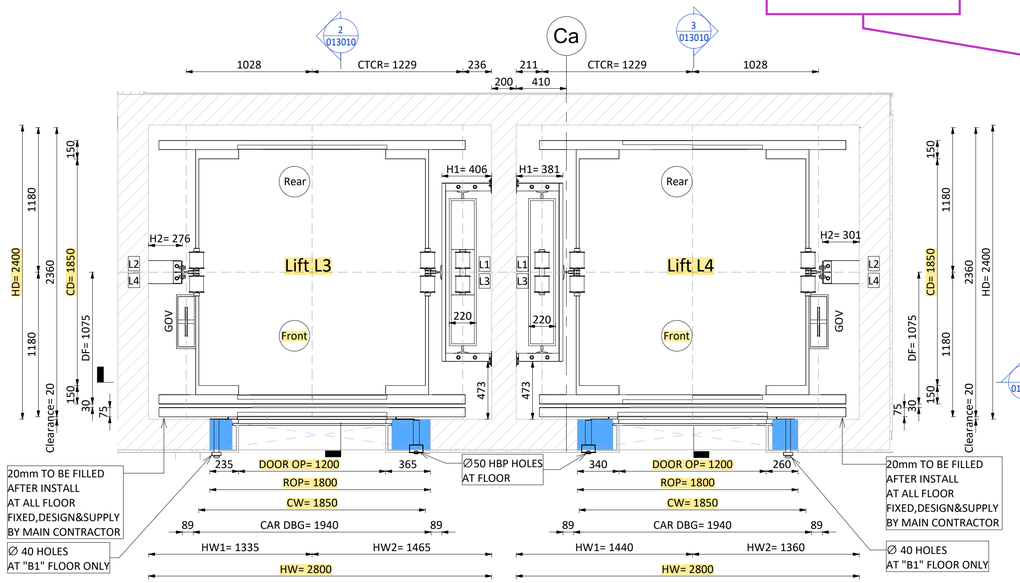

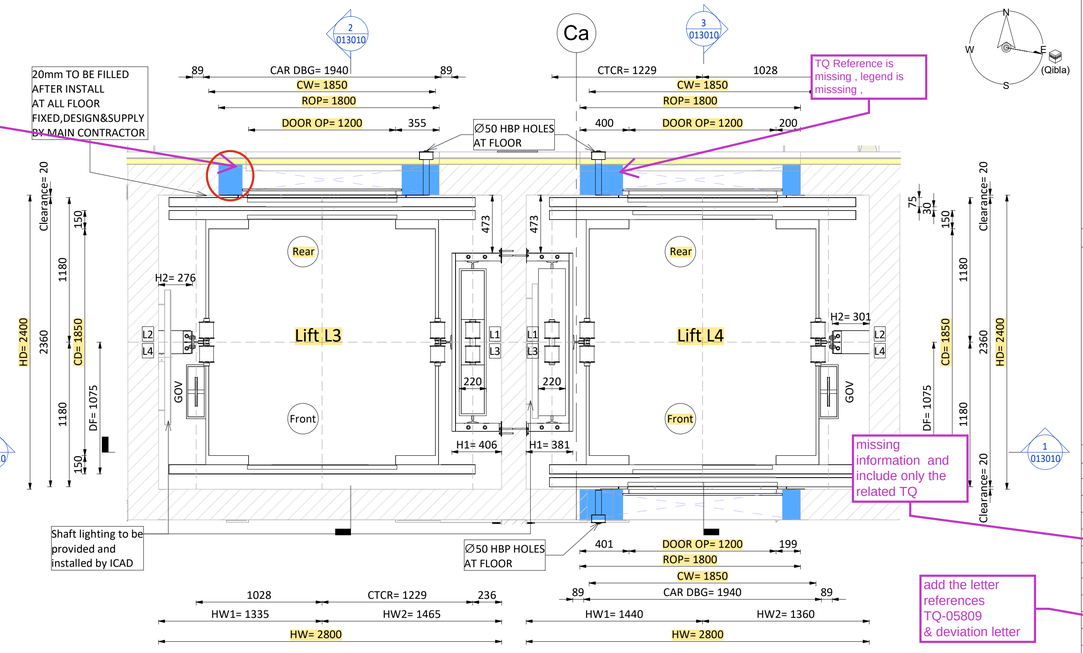

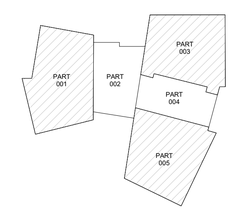

KEY PLAN

GENERAL NOTES: ALL LEVELS SHOWN ON THE DRAWING ARE CHART DATUM LEVELS PROJECT LEVEL+0.000 = +3.700 CHART DATUM.

Refer to:
For Hooks design TQ-OPE-MBL-JCDC-00952
Electrical Panels distribution: JOH-ICD-S5-01-056-XXX-03-SD-EL-011630_1
wiring diagram opera lift
Acoustic Letter: L-OTIS-MBL-OPE-26-0015

DRAWING / DOCUMENT REFERENCE

NO.	NUMBER	TITLE	REV
01	L-03	JOH-HLA-S4-01-056-XXX-01-DR-AR-011110	F00
02		JOH-BHC-S4-01-056-XXX-XX-DR-VT-015001	
03		JOH-BHC-S4-01-056-XXX-XX-DR-VT-010001	
04		JOH-BHC-S4-01-056-005-ZZ-DR-VT-013001	
05		JOH-BHC-S4-01-056-005-ZZ-DR-VT-011001	
06		TQ-OPE-MBL-JCDC-00222	
07		TQ-OPE-MBL-JCDC-00952	
08		JCD-OPE-MBL-MR-003-NMR-601-03	
09		JCD-OPE-MBL-MR-003-NMR-602-01	
10		TQ-OPE-MBL-JCDC-01299	
11		TQ-OPE-MBL-JCDC-01308	

1 Hoist Way Plan At "B1" Floor (Front) - ELEV-L3 & L4

@ level - 500

1 : 25

SCEC – K&A Reviewed
Civil
Arch.
Elec.
ELV.
Mech.
Acoustic

SCEC – K&A Reviewed
Code B – Approved with Comments (Do not Resubmit)

CONTROLLED COPY
MBL IFC
JEDDAH OPERA HOUSE PROJECT
QA/QC Department
MBL QAM
Engr. Mudassar Altaf

1-shaft size to be extracted from federated model
2-contractor must take in consideration as built dimensions and conditions prior execution
3- FFL Levels shall match the federated model levels and as per site conditions
4- Elevator Car Sizes/**dimensions** and Floors Being Served by the Elevators shall be as per approved TBE and further to OTIS letter **TQ-05809** and lift deviation letter ref:**TQ-OPE-MBL-JCDC-01330**
5- car interior finishes shall be submitted in a separate submission for approval
6-HOISTWAY PRESSURIZATION is not provided contractor shall confirm its requirement prior execution
7-Contractor to update the missing reference when submitting the coordination drawing with wall finishing
8-hoistway entrance to be verified by contractor by the contractor to align with OTIS proposed drawings
9-stair ladder shall be submitted separately for approval
Structural comments:
8-Structural design of brackets including their anchor bolts into the concrete walls for the lift loads is to be submitted for checking and approval.
Otherwise, evident for its adequacy is to be provided.

Disclaimer :K&A Khatib Alami – Saudi Consolidated Engineering review and/or approval does not relieve the Contractor from obligation to adhere to Contract Documents. The Contractor remains fully responsible for the accuracy, completeness, coordination, and compliance of all submitted documents and works

No objection from Electrical side with the following general comments:
1.Contractor to clarify lighting supply requirements and provide locations and provisions for shaft lighting, cabin lighting. emergency lighting, and ventilation fans.
2.Contractor to confirm compatibility with other interfaced systems within the project: BMS, PMS, CCTV, Fire alarm system, Intercom, and cabin speakers as noted on drawings.
3.Contractor to submit wiring diagrams for controller, car operating panel (COP), hall position indicators (HBP), and emergency & inspection panels (E&I).
4.Contractor to clarify the requirements for pit inspection reset switch and fireman service switch installations. (If any Contractor to Provide grounding and earthing details for elevator equipment, guide rails, and machine component.

oist Way Plan At "G" Floor (Front&Rear) - ELEV-L3 & L4


@ level +3700

: 25

ELEV-L3 ELEVATOR GENERAL SPECIFICATIONS	
Lift Number	ELEV.L3
CABIN INTERNAL SIZE(WXDXH)	1850X1850X2600
CAPACITY	1600 Kg
CLEAR ENTRANCE	1200x2400
CONTROL	VVVF
CONTROL SYSTEM	SIMPLEX FULL COLLECTIVE
COUNTERWEIGHT SAFETY	NO
DOOR TYPE	CLD1
EMERGENCY EXITS	-
FRONT OPENING	1
HEAT RELEASE	1616Kcal/h
HOISTWAY SIZE(HWXHD)	2800X2400
LIFT NUMBER	ELV.L3
LIGHTING SUPPLY	220V 60HZ
MIN.FLOOR HEIGHT	-
NO. OF FLOOR	4
NO. OF OPENINGS	4
NO. OF UNITS	1
NON-STOP FLOORS	-
NON-STOP FLOORS NAMES	-
NUMBER OF PASSENGERS	21P
OVERHEAD	5400mm
PIT DEPTH	1600mm
POWER SUPPLY	380V 3P 60HZ
PRODUCT NO.	GeN2 MRL
RATED CURRENT(A)	25.6
REAR OPENING	3
ROPING	2:1
SPEED(m/s)	1.00
START CURRENT(A)	28.4
SYSTEM POWER(KW)	13.5
TRAVEL	14875 mm
USE	PASSENGER LIFT

ELEV-L4 ELEVATOR GENERAL SPECIFICATIONS	
Lift Number	ELEV.L4
CABIN INTERNAL SIZE(WXDXH)	1850X1850X2600
CAPACITY	1600 kg
CLEAR ENTRANCE	1200x2400
CONTROL	VVVF
CONTROL SYSTEM	SIMPLEX FULL COLLECTIVE
COUNTERWEIGHT SAFETY	NO
DOOR TYPE	CLD1
EMERGENCY EXITS	-
FRONT OPENING	3
HEAT RELEASE	1616Kcal/h
HOISTWAY SIZE(HWXHD)	2800X2400
LIFT NUMBER	ELV.L4
LIGHTING SUPPLY	220V 60HZ
MIN.FLOOR HEIGHT	-
NO. OF FLOOR	4
NO. OF OPENINGS	6
NO. OF UNITS	1
NON-STOP FLOORS	-
NON-STOP FLOORS NAMES	-
NUMBER OF PASSENGERS	21P
OVERHEAD	5400mm
PIT DEPTH	1600mm
POWER SUPPLY	380V 3P 60HZ
PRODUCT NO.	GeN2 MRL
RATED CURRENT(A)	25.6
REAR OPENING	3
ROPING	2:1
SPEED(m/s)	1.00
START CURRENT(A)	28.4
SYSTEM POWER(KW)	13.5
TRAVEL	14875 mm
USE	PASSENGER LIFT

REACTIONS FORCE (KN)		
Car side rail	CWT guide rail	Pit reaction
R= 41	R= 15	U= 165
R1= 2.47	R1= 1.13	V= 132
R2= 3.14	R2= 0.3	

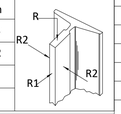

LEGEND	
HW	HOIST WAY WIDTH
HD	HOIST WAY DEPTH
CRH	CAR ROUGH HEIGHT
DOOR OP	DOOR OPENING
ROP	ROUGH OPENING
CW	CAR WIDTH
CD	CAR DEPTH
CH	CAR HEIGHT
DBG	DISTANCE BETWEEN GUARDRAIL
CWT	COUNTERWEIGHT
E&I PANEL	EMERGENCY & INSPECTION PANEL
G.O.V	CAR GOVERNOR
COP	CAR OPERATING PANEL
HBP	HALL POSITION INDICATOR


NOTE No.:
FRONT WALLS FINISHES & ARCHITRAVES TO BE BUILT-BY CLIENT1 AFTER THE INSTALLATION OF THE (LANDING) EXTERNAL DOORS.


IMPORTANT NOTE FOR MAIN CONTRACTOR.
FREEDOM OF ACCESS MUST BE AVAILABLE FOR POINT OF ENTRY INTO THE BUILDING UP TO THE ELEVATOR HOIST WAY AND THE FRONT WALLS OF THE HOIST WAY AT MAIN FLOOR TO BE LEFT OPEN FOR FULL WIDTH AND HEIGHT TO PERMIT ENTRY OF OUR EQUIPMENT.

3 Hoist Way Plan At "1" Floor (Rear) - ELEV-L3 & L4


@ level + 9300

1 : 25

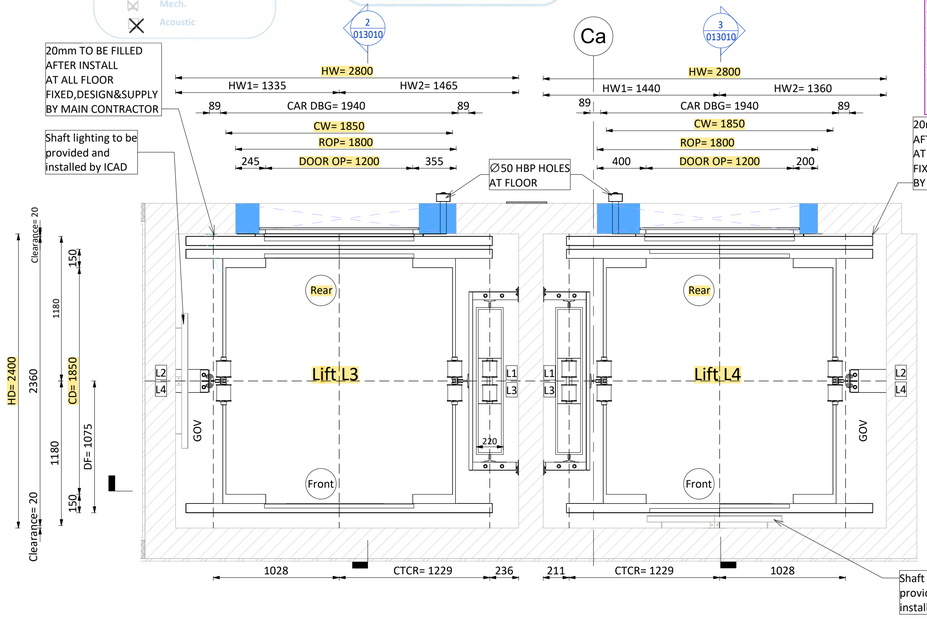

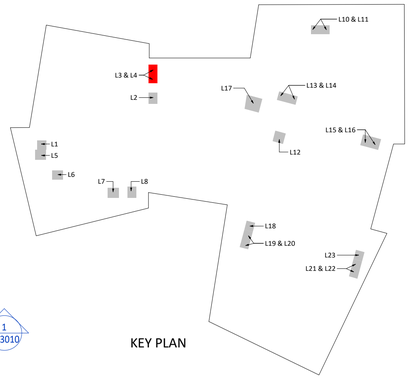

9-this note is rejected , it is contractor sole responsibility to submit a complete coordinated shop-drawing connection details with wall finishes ,architraves floor threshold connection and liner/top door connection

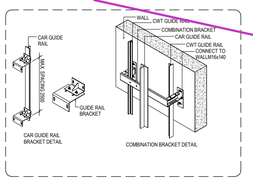

MBL to provide a comprehensive Method Statement describing the procedure for filling all gaps and correcting / adjusting the rough openings for doors.

dar Bur Al Handasah consultants (Shair and Partners)
Checked and Reviewed

REVIEWED BY DISCIPLINE	SIGNATURE	DATE
ARCHITECTURAL	[illegible]	[illegible]
STRUCTURAL	[illegible]	2026-06-04
MECHANICAL	[illegible]	2026-06-04
PLUMBING	[illegible]	[illegible]
ELECTRICAL	[illegible]	[illegible]
ICT	[illegible]	2026-06-04
ADDITIONAL DISCIPLINES TO BE ADDED AS REQUIRED		

REV	DATE	BY	DESCRIPTION	CHK	APD
S00	31-MAY-2026	AK	Issued for Approval	SS	AB

DRAWING STATUS: CONSTRUCTION SHOPDRAWING

CLIENT: شركة وسط جدة للتطوير Jeddah Central Development Co.

LEAD DESIGN CONSULTANTS: Henning Larsen
LEAD ENGINEERING CONSULTANT: BURO HAPPOLD
PROJECT SUPERVISION CONSULTANT: K&A
GENERAL CONTRACTOR: MBL
REVIEWER: dar
SUB CONTRACTOR: OTIS ELEVATOR COMPANY (SAUDI ARABIA) LIMITED

PROJECT: JEDDAH OPERA HOUSE


TITLE: OPERA BUILDING
VERTICAL TRANSPORTATION
PART 002
PLANS - LIFT SHAFT SHEET 01 OF 02 (L03 & L04)

SCALE @ A1:	CHECKED:	APPROVED:
As indicated	SS	AB
PROJECT No:	DESIGNED:	DRAWN:	DATE:
440014	AK	PR	31-MAY-2026

DRAWING No: JOH-OTS-S5-01-056-002-ZZ-SD-VT-011010 REV: S00

MODEL FILE REF: JOH-OTS-S5-01-056-XXX-ZZ-M3-VT-010001


ⓒ JCDC

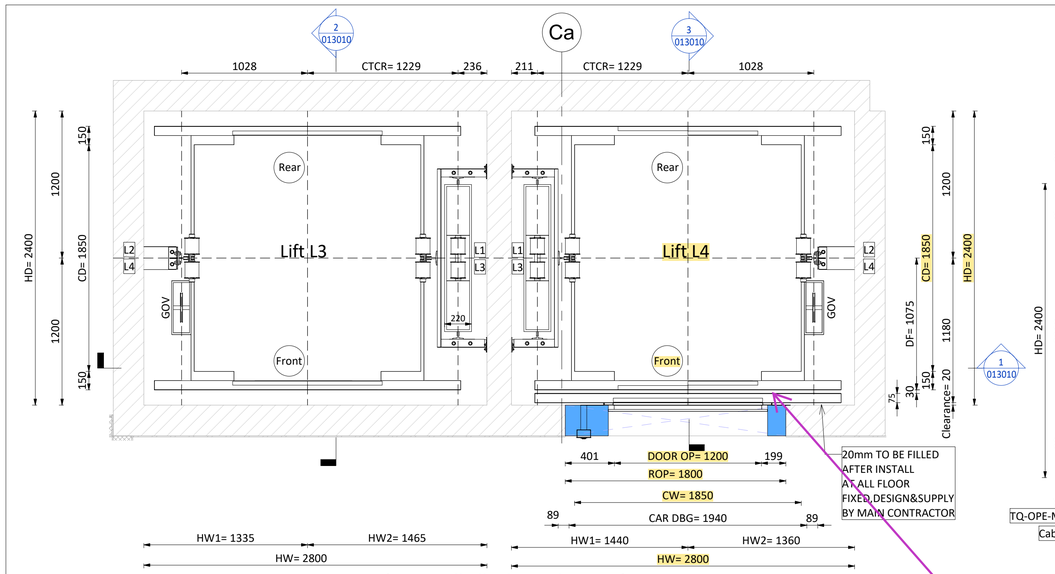

5 Hoist Way Plan At "2" Floor (Front) - ELEV-L3 & L4 @ level +12625

1 : 25

fire stop application detail to be submitted separately for review and FLS approval

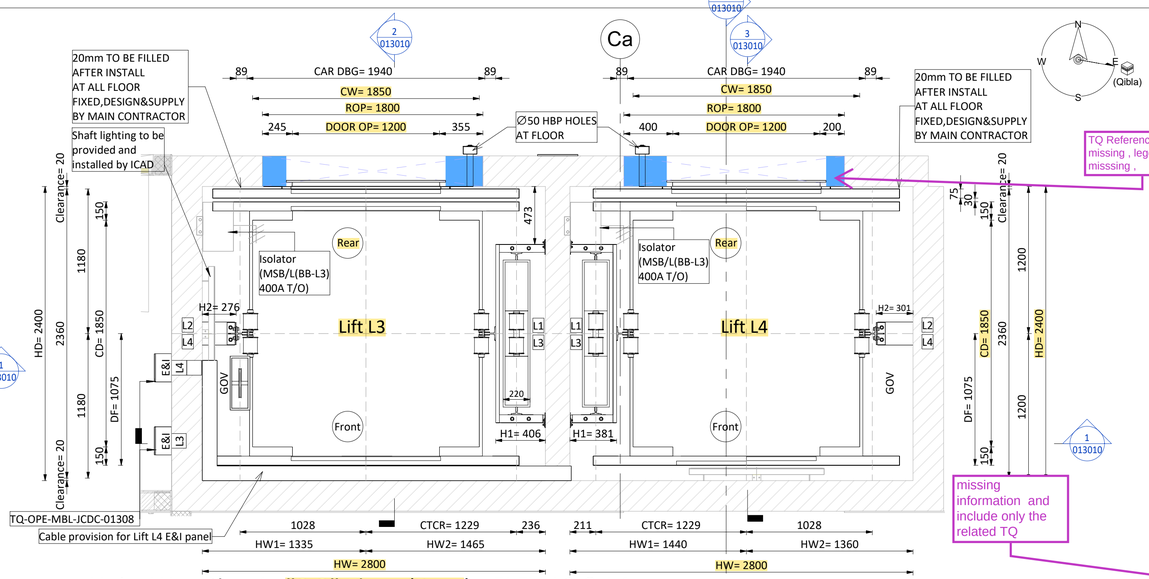


4 Hoist Way Plan At "2.2" Floor (Rear) - ELEV-L3 & L4 @ level +14375

1 : 25

TQ Reference is missing , legend is misssing ,

missing information and include only the related TQ

add the letter references TQ-05809 & deviation letter

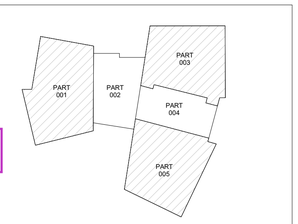

KEY PLAN

GENERAL NOTES: ALL LEVELS SHOWN ON THE DRAWING ARE CHART DATUM LEVELS PROJECT LEVEL+0.000 = +3.700 CHART DATUM.

Refer to:
For Hooks design TQ-OPE-MBL-JCDC-00952
Electrical Panels distribution: JOH-ICD-S5-01-056-XXX-03-SD-EL-011630_1 wiring diagram opera lift
Acoustic Letter: L-OTIS-MBL-OPE-26-0015

DRAWING / DOCUMENT REFERENCE

NO.	NUMBER	TITLE	REV.
01	L-03	JOH-HLA-S4-01-056-XXX-01-DR-AR-011110	F00
02		JOH-BHC-S4-01-056-XXX-XX-DR-VT-015001	
03		JOH-BHC-S4-01-056-XXX-XX-DR-VT-010001	
04		JOH-BHC-S4-01-056-005-ZZ-DR-VT-013001	
05		JOH-BHC-S4-01-056-005-ZZ-DR-VT-011001	
06		TQ-OPE-MBL-JCDC-00222	
07		TQ-OPE-MBL-JCDC-00952	
08		JCD-OPE-MBL-MR-003-NMR-601-03	
09		JCD-OPE-MBL-MR-003-NMR-602-01	
10		TQ-OPE-MBL-JCDC-01299	
11		TQ-OPE-MBL-JCDC-01308	

REVIEWED BY DISCIPLINE	SIGNATURE	DATE
ARCHITECTURAL	[illegible]	[illegible]
STRUCTURAL	[illegible]	2026-06-04
MECHANICAL	Sh.A	2026-06-04
PLUMBING	[illegible]	[illegible]
ELECTRICAL	[illegible]	[illegible]
ICT	Sh.A	2026-06-04
ADDITIONAL DISCIPLINES TO BE ADDED AS REQUIRED		

SCEC – K&A Reviewed
Civil
Arch.
Elec.
ELV.
Mech.
Acoustic

SCEC – K&A Reviewed
Code B – Approved with Comments (Do not Resubmit)

CONTROLLED COPY
MBL IFC
JEDDAH OPERA HOUSE PROJECT
QA/QC Department
MBL QAM
Engr. Mudassar Altaf

REV	DATE	BY	DESCRIPTION	CHK	APD
S00	31-MAY-2026	AK	Issued for Approval	SS	AB

DRAWING STATUS: CONSTRUCTION SHOPDRAWING

CLIENT: شركة جدة للتطوير Jeddah Central Development Co.

LEAD DESIGN CONSULTANTS: Henning Larsen

LEAD ENGINEERING CONSULTANT: BURO HAPPOLD

PROJECT SUPERVISION CONSULTANT: KHATIB & ALAMI

GENERAL CONTRACTOR: MBL

REVIEWER: dar

SUB CONTRACTOR: OTIS ELEVATOR COMPANY (SAUDI ARABIA) LIMITED — OTIS

PROJECT: JEDDAH OPERA HOUSE

TITLE: OPERA BUILDING
VERTICAL TRANSPORTATION
PART 002
PLANS - LIFT SHAFT SHEET 02 OF 02 (L03 & L04)


SCALE @ A1:	CHECKED:	APPROVED:
1 : 25	SS	AB

PROJECT No:	DESIGNED:	DRAWN:	DATE:
440014	AK	PR	31-MAY-2026

DRAWING No: JOH-OTS-S5-01-056-002-ZZ-SD-VT-011011 REV: S00


MODEL FILE REF: JOH-OTS-S5-01-056-XXX-ZZ-M3-VT-010001

© JCDC

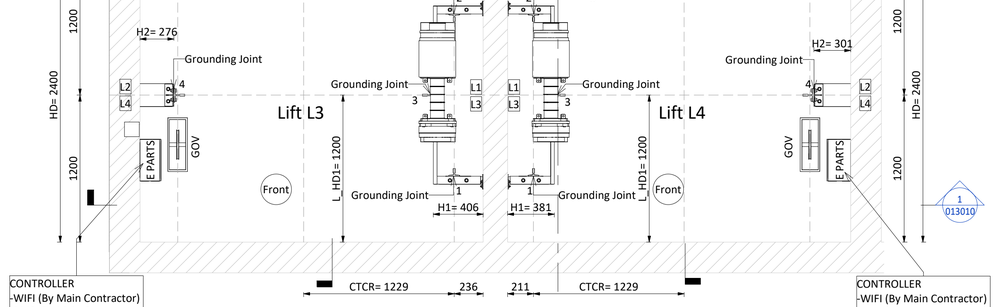

1 Machine Plan Level - ELEV-L3 & L4


1 : 25

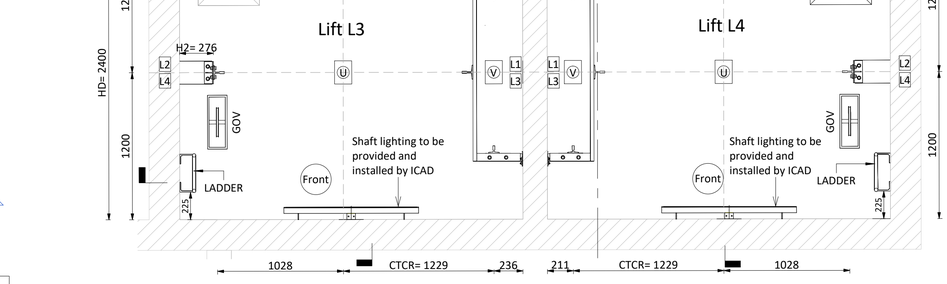

2 Hoist Way Pit Plan - ELEV-L3 & L4

1 : 25

No objection from Electrical side with the following general comments:
1.Contractor to clarify lighting supply requirements and provide locations and provisions for shaft lighting, cabin lighting, emergency lighting, and ventilation fans.
2.Contractor to confirm compatibility with other interfaced systems within the project: BMS, PMS, CCTV, Fire alarm system, Intercom, and cabin speakers as noted on drawings.
3.Contractor to submit wiring diagrams for controller, car operating panel (COP), hall position indicators (HBP), and emergency & inspection panels (E&I).
4.Contractor to clarify the requirements for pit inspection reset switch and fireman service switch installations. (If any Contractor to Provide grounding and earthing details for elevator equipment, guide rails, and machine component.

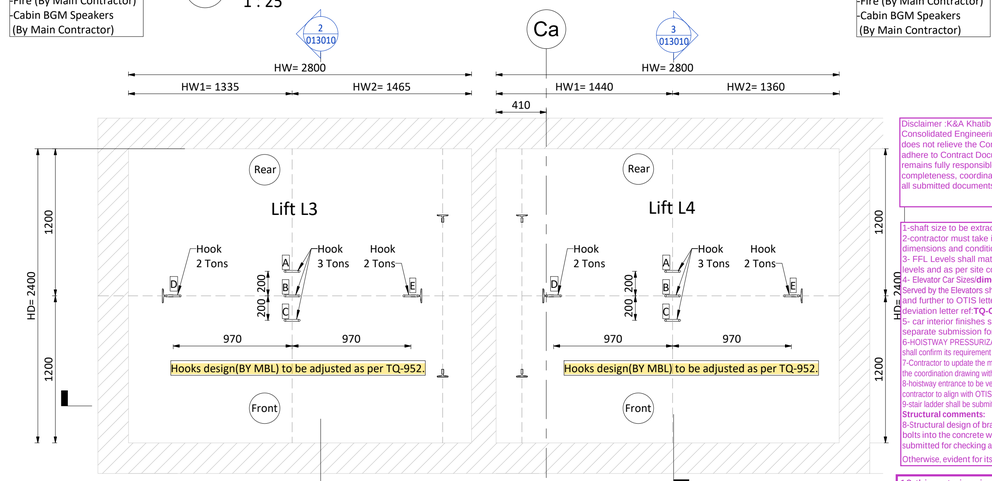

3 Top Hoist Way Hook Plan - ELEV-L3 & L4

1 : 25

Disclaimer :K&A Khatib Alami – Saudi Consolidated Engineering review and/or approval does not relieve the Contractor from obligation to adhere to Contract Documents. The Contractor remains fully responsible for the accuracy, completeness, coordination, and compliance of all submitted documents and works

1-shaft size to be extracted from federated model
2-contractor must take in consideration as built dimensions and conditions prior execution
3- FFL Levels shall match the federated model levels and as per site conditions
4- Elevator Car Sizes/**dimensions** and Floors Being served by the Elevators shall be as per approved TBE and further to OTIS letter **TQ-05809** and lift Deviation letter ref:**TQ-OPE-MBL-JCDC-01330**
5- car interior finishes shall be submitted in a separate submission for approval
6-HOISTWAY PRESSURIZATION is not provided contractor shall confirm its requirement prior execution
7-Contractor to update the missing reference when submitting the coordination drawing with wall finishing
8-hoistway entrance to be verified by contractor by the contractor to align with OTIS proposed drawings
9-stair ladder shall be submitted separately for approval
Structural comments:
8-Structural design of brackets including their anchor bolts into the concrete walls for the lift loads is to be submitted for checking and approval.
Otherwise, evident for its adequacy is to be provided.

MBL to provide a comprehensive Method Statement describing the procedure for filling all gaps and correcting / adjusting the rough openings for doors.

Checked and Reviewed

REACTIONS FORCE (KN)

Car side rail	CWT guide rail	Pit reaction	
R= 41	R= 15	U= 165	R, R2, R1, R2
R1= 2.47	R1= 1.13	V= 132	
R2= 3.14	R2= 0.3		

NOTE No.:
FRONT WALLS,FINISHES & ARCHITRAVES TO BE BUILT (BY CLIENT) AFTER THE INSTALLATION OF THE (LANDING) EXTERNAL DOORS.

IMPORTANT NOTE FOR MAIN CONTRACTOR.
FREEDOM OF ACCESS MUST BE AVAILABLE FOR POINT OF ENTRY INTO THE BUILDING UP TO THE ELEVATOR HOIST WAY AND THE FRONT WALLS OF THE HOIST WAY AT MAIN FLOOR TO BE LEFT OPEN FOR FULL WIDTH AND HEIGHT TO PERMIT ENTRY OF OUR EQUIPMENT.


10-this note is rejected , it is contractor sole responsibility to submit a complete coordinated shop-drawing connection details with wall finishes ,architraves floor threshold connection and linter/ top door connection

ELEV-L3 ELEVATOR GENERAL SPECIFICATIONS

Lift Number	ELEV.L3
CABIN INTERNAL SIZE(WXDXH)	1850X1850X2600
CAPACITY	1600 Kg
CLEAR ENTRANCE	1200x2400
CONTROL	VVVF
CONTROL SYSTEM	SIMPLEX FULL COLLECTIVE
COUNTERWEIGHT SAFETY	NO
DOOR TYPE	CLD1
EMERGENCY EXITS	-
FRONT OPENING	1
HEAT RELEASE	1616Kcal/h
HOISTWAY SIZE(HWXHD)	2800X2400
LIFT NUMBER	ELV.L3
LIGHTING SUPPLY	220V 60HZ
MIN.FLOOR HEIGHT	-
NO. OF FLOOR	4
NO. OF OPENINGS	4
NO. OF UNITS	1
NON-STOP FLOORS	-
NON-STOP FLOORS NAMES	-
NUMBER OF PASSENGERS	21P
OVERHEAD	5400mm
PIT DEPTH	1600mm
POWER SUPPLY	380V 3P 60HZ
PRODUCT NO.	GeN2 MRL
RATED CURRENT(A)	25.6
REAR OPENING	3
ROPING	2:1
SPEED(m/s)	1.00
START CURRENT(A)	28.4
SYSTEM POWER(KW)	13.5
TRAVEL	14875 mm
USE	PASSENGER LIFT Public

ELEV-L4 ELEVATOR GENERAL SPECIFICATIONS


Lift Number	ELEV.L4
CABIN INTERNAL SIZE(WXDXH)	1850X1850X2600
CAPACITY	1600 kg
CLEAR ENTRANCE	1200x2400
CONTROL	VVVF
CONTROL SYSTEM	SIMPLEX FULL COLLECTIVE
COUNTERWEIGHT SAFETY	NO
DOOR TYPE	CLD1
EMERGENCY EXITS	-
FRONT OPENING	3
HEAT RELEASE	1616Kcal/h
HOISTWAY SIZE(HWXHD)	2800X2400
LIFT NUMBER	ELV.L4
LIGHTING SUPPLY	220V 60HZ
MIN.FLOOR HEIGHT	-
NO. OF FLOOR	4
NO. OF OPENINGS	6
NO. OF UNITS	1
NON-STOP FLOORS	-
NON-STOP FLOORS NAMES	-
NUMBER OF PASSENGERS	21P
OVERHEAD	5400mm
PIT DEPTH	1600mm
POWER SUPPLY	380V 3P 60HZ
PRODUCT NO.	GeN2 MRL
RATED CURRENT(A)	25.6
REAR OPENING	3
ROPING	2:1
SPEED(m/s)	1.00
START CURRENT(A)	28.4
SYSTEM POWER(KW)	13.5
TRAVEL	14875 mm
USE	PASSENGER LIFT Public

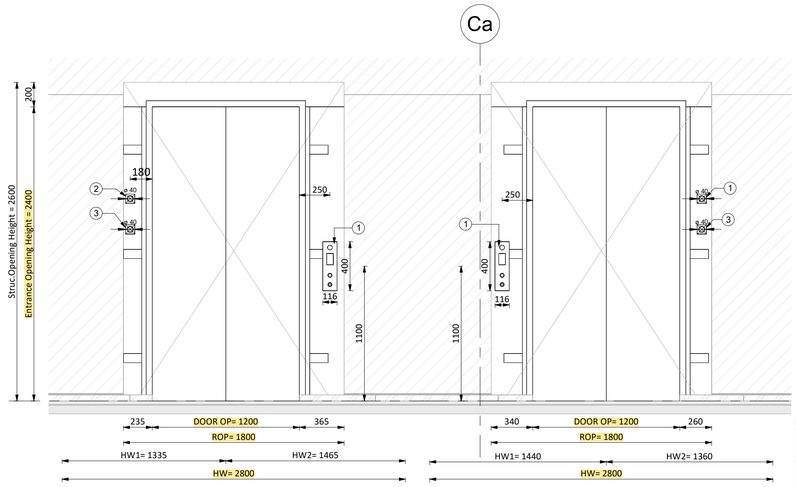

1.HALL BUTTON(HBP)
116X400 THROUGH HOLE ,IN THE DISCRETIONARY FLOOR
2.FIREMAN SERVICE (FSS)
Φ40mm THROUGH HOLE, IN THE MAIN FLOOR
3. PIT INSPECTION RESET SW
Φ40mm ONLY FOR PIT LANDING
4.E&I PANEL.

1 Door Elevation At "B1" Floor (FRONT) - ELEV-L3 & L4

1 : 25

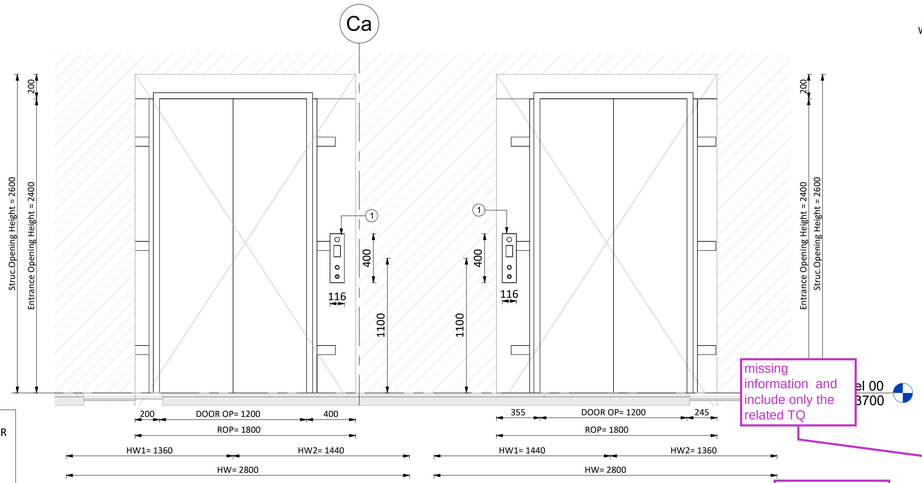


missing information and include only the related TQ

add the letter references TQ-05809 & deviation letter


2 Door Elevation At "G & 1" Floor (REAR) - ELEV-L3 & L4

1 : 25

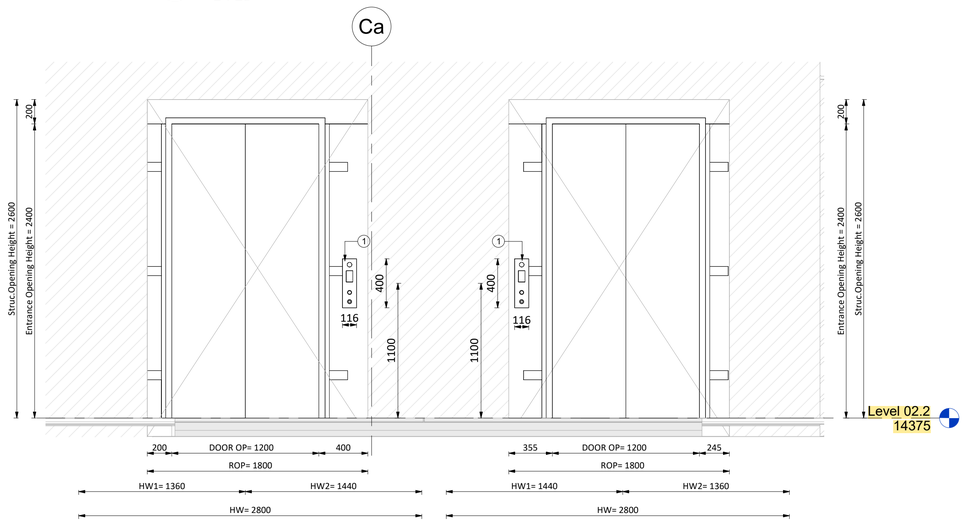

3 Door Elevation At "2" Floor (REAR) - ELEV-L3 & L4


1 : 25

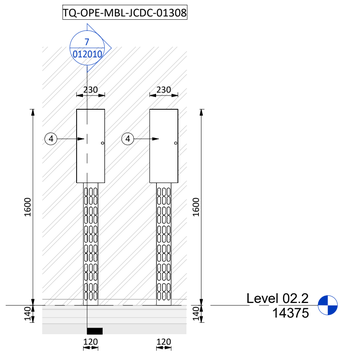

CONTROLLED COPY
MBL IFC
JEDDAH OPERA HOUSE PROJECT
QA/QC Department
MBL QAM
Engr. Mudassar Altaf

4 E&I PANEL Elevation At "2" Floor (SIDE) - ELEV-L3 & L4

1 : 25

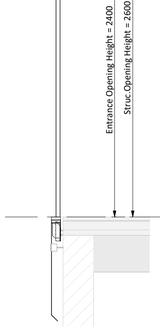


1-shaft size to be extracted from federated model
2-contractor must take in consideration as built dimensions and conditions prior execution
3- FFL Levels shall match the federated model levels and as per site conditions
4- Elevator Car Sizes/**dimensions** and Floors Being Served by the Elevators shall be as per approved TBE and further to OTIS letter **TQ-05809** and lift deviation letter ref:**TQ-OPE-MBL-JCDC-01330**
5- car interior finishes shall be submitted in a separate submission for approval
6-HOISTWAY PRESSURIZATION is not provided contractor shall confirm its requirement prior execution
7-Contractor to update the missing reference when submitting the coordination drawing with wall finishing
8-hoistway entrance to be verified by contractor by the contractor to align with OTIS proposed drawings
9-stair ladder shall be submitted separately for approval
Structural comments:
8-Structural design of brackets including their anchor bolts into the concrete walls for the lift loads is to be submitted for checking and approval.
Otherwise, evident for its adequacy is to be provided.

SCEC – K&A Reviewed
Code B – Approved with Comments
(Do not Resubmit)

SCEC – K&A Reviewed
Civil
Arch.
Elec.
ELV.
Mech.
Acoustic

No objection from Electrical side with the following general comments:
1.Contractor to clarify lighting supply requirements and provide locations and provisions for shaft lighting, cabin lighting, emergency lighting, and ventilation fans.
2.Contractor to confirm compatibility with other interfaced systems within the project: BMS, PMS, CCTV, Fire alarm system, Intercom, and cabin speakers as noted on drawings.
3.Contractor to submit wiring diagrams for controller, car operating panel (COP), hall position indicators (HBP), and emergency & inspection panels (E&I).
4.Contractor to clarify the requirements for pit inspection reset switch and fireman service switch installations. (If any Contractor to Provide grounding and earthing details for elevator equipment, guide rails, and machine component.

Simplex Units

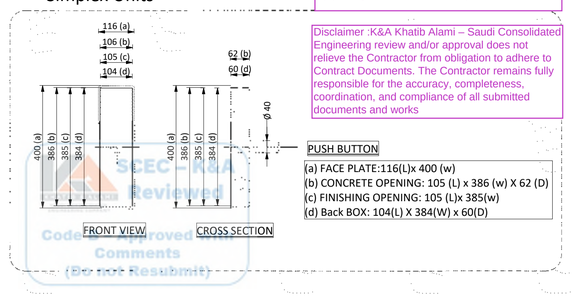


PUSH BUTTON

(a) FACE PLATE:116(L)x 400 (w)
(b) CONCRETE OPENING: 105 (L) x 386 (w) X 62 (D)
(c) FINISHING OPENING: 105 (L)x 385(w)
(d) Back BOX: 104(L) X 384(W) x 60(D)


Disclaimer :K&A Khatib Alami – Saudi Consolidated Engineering review and/or approval does not relieve the Contractor from obligation to adhere to Contract Documents. The Contractor remains fully responsible for the accuracy, completeness, coordination, and compliance of all submitted documents and works

SCEC – K&A Reviewed
Code B – Approved with Comments
(Do not Resubmit)

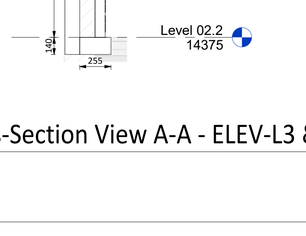


7 Cross-Section View A-A - ELEV-L3 & L4

1 : 25

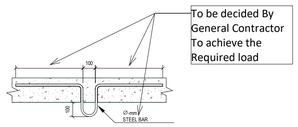

Hook Fixation Detail

Hooks Design,Supply & Install By Main Contractor

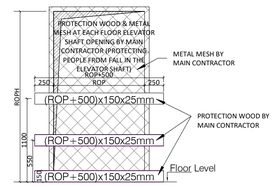


Protection Elevation Detail
At Each Elevator Shaft Opening

MBL to provide a comprehensive Method Statement describing the procedure for filling all gaps and correcting / adjusting the rough openings for doors.

dar Dar Al-Handasah consultants (Shair and Partners)
Checked and Reviewed

LEGEND	
HW	HOIST WAY WIDTH
HD	HOIST WAY DEPTH
CRH	CAR ROUGH HEIGHT
DOOR OP	DOOR OPENING
ROP	ROUGH OPENING
CW	CAR WIDTH
CD	CAR DEPTH
CH	CAR HEIGHT
DBG	DISTANCE BETWEEN GUARDRAIL
CWT	COUNTERWEIGHT
E&I PANEL	EMERGENCY & INSPECTION PANEL
G.O.V	CAR GOVERNOR
COP	CAR OPERATING PANEL
HBP	HALL BUTTON POSITION INDICATOR

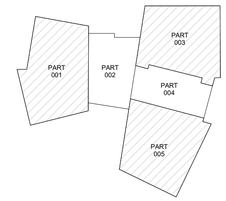

KEY PLAN

GENERAL NOTES: ALL LEVELS SHOWN ON THE DRAWING ARE CHART DATUM LEVELS PROJECT LEVEL+0.000 = +3.700 CHART DATUM.

Refer to:
For Hooks design TQ-OPE-MBL-JCDC-00952
Electrical Panels distribution: JOH-ICD-S5-01-056-XXX-03-SD-EL-011630_1
wiring diagram opera lift
Acoustic Letter: L-OTIS-MBL-OPE-26-0015

DRAWING / DOCUMENT REFERENCE

NO.	NUMBER	TITLE	REV.
01	L-03	JOH-HLA-S4-01-056-XXX-01-DR-AR-011110	F00
02		JOH-BHC-S4-01-056-XXX-XX-DR-VT-015001	
03		JOH-BHC-S4-01-056-XXX-XX-DR-VT-010001	
04		JOH-BHC-S4-01-056-005-ZZ-DR-VT-013001	
05		JOH-BHC-S4-01-056-005-ZZ-DR-VT-011001	
06		TQ-OPE-MBL-JCDC-00222	
07		TQ-OPE-MBL-JCDC-00952	
08		JCD-OPE-MBL-MR-003-NMR-601-03	
09		JCD-OPE-MBL-MR-003-NMR-602-01	
10		TQ-OPE-MBL-JCDC-01299	
11		TQ-OPE-MBL-JCDC-01308	

REVIEWED BY DISCIPLINE	SIGNATURE	DATE
ARCHITECTURAL		
STRUCTURAL		26-06-04
MECHANICAL		26-06-04
PLUMBING		
ELECTRICAL		
ICT		2026-06-04
ADDITIONAL DISCIPLINES TO BE ADDED AS REQUIRED		

REV	DATE	BY	DESCRIPTION	CHK	APD
S00	31-MAY-2026	AK	Issued for Approval	SS	AB

DRAWING STATUS: CONSTRUCTION SHOPDRAWING

CLIENT: شركة وسط جدة للتطوير Jeddah Central Development Co.

LEAD DESIGN CONSULTANTS: Henning Larsen

LEAD ENGINEERING CONSULTANT: BURO HAPPOLD

PROJECT SUPERVISION CONSULTANT: K&A

GENERAL CONTRACTOR: MBL

REVIEWER: dar

SUB CONTRACTOR: OTIS ELEVATOR COMPANY SAUDI ARABIA LIMITED

PROJECT: JEDDAH OPERA HOUSE

TITLE: OPERA BUILDING
VERTICAL TRANSPORTATION
PART 002
ELEVATIONS - LIFT SHAFT (L03 & L04)


SCALE @ A1:	CHECKED:	APPROVED:
As indicated	SS	AB

PROJECT No:	DESIGNED:	DRAWN:	DATE:
440014	AK	PR	31-MAY-2026

DRAWING No: JOH-OTS-S5-01-056-002-ZZ-SD-VT-012010 REV: S00

MODEL FILE REF: JOH-OTS-S5-01-056-XXX-ZZ-M3-VT-010001

© JCDC

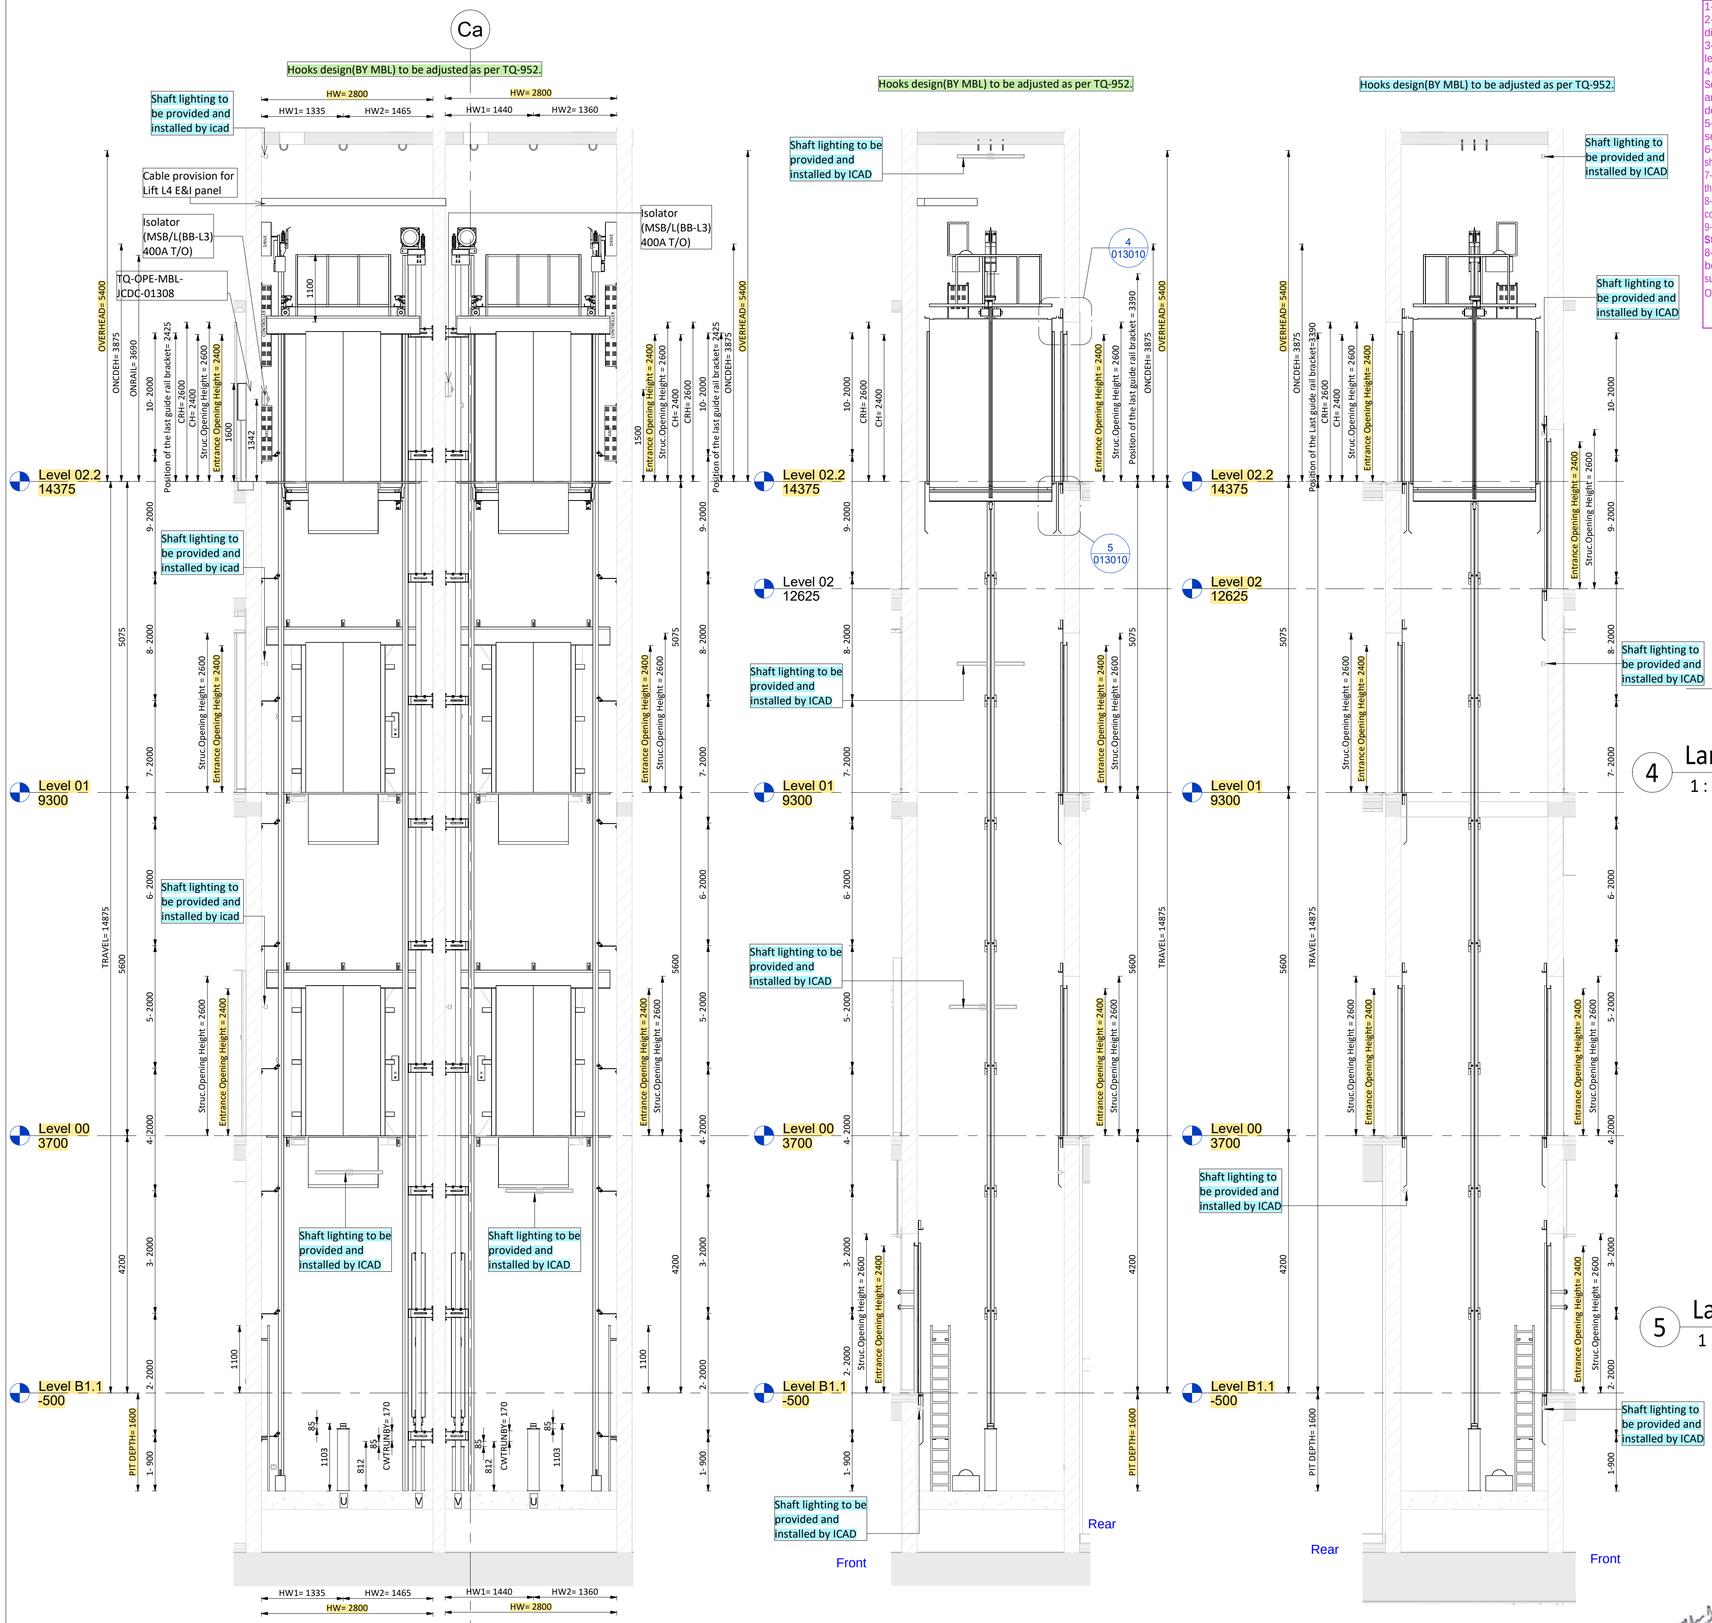


1 Section "A" - ELEV-L3 & L4
1 : 50

2 Section "B" - ELEV-L3
1 : 50

3 Section "B" - ELEV-L4
1 : 50

1-shaft size to be extracted from federated model
2-contractor must take in consideration as built dimensions and conditions prior execution
3- FFL Levels shall match the federated model levels and as per site conditions
4- Elevator Car Sizes/**dimensions** and Floors Being Served by the Elevators shall be as per approved TBE and further to OTIS letter **TQ-05809** and lift deviation letter ref:**TQ-OPE-MBL-JCDC-01330**
5- car interior finishes shall be submitted in a separate submission for approval
6-HOISTWAY PRESSURIZATION is not provided contractor shall confirm its requirement prior execution
7-Contractor to update the missing reference when submitting the coordination drawing with wall finishing
8-hoistway entrance to be verified by contractor by the contractor to align with OTIS proposed drawings
9-stair ladder shall be submitted separately for approval
Structural comments:
8-Structural design of brackets including their anchor bolts into the concrete walls for the lift loads is to be submitted for checking and approval.
Otherwise, evident for its adequacy is to be provided.

missing information and include only the related TQ

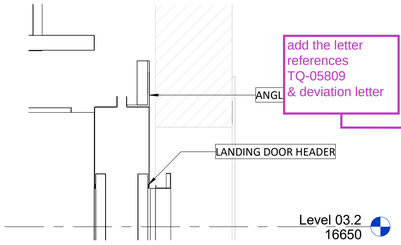


add the letter references TQ-05809 & deviation letter

4 Landing Door Header Detail - ELEV-L3 & L4
1 : 10

SCEC – K&A Reviewed
Civil
Arch.
Elec.
ELV.
Mech.
Acoustic

SCEC – K&A Reviewed
Code B – Approved with Comments
(Do not Resubmit)

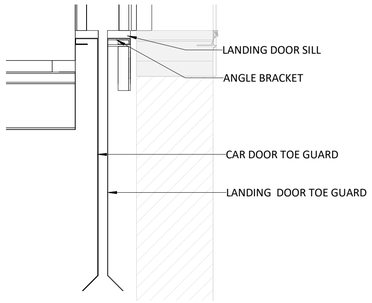


5 Landing Door Bottom Detail - ELEV-L3 & L4
1 : 10

No objection from Electrical side with the following general comments:
1.Contractor to clarify lighting supply requirements and provide locations and provisions for shaft lighting, cabin lighting, emergency lighting, and ventilation fans.
2.Contractor to confirm compatibility with other interfaced systems within the project; BMS, PMS, CCTV, Fire alarm system, Intercom, and cabin speakers as noted on drawings.
3.Contractor to submit wiring diagrams for controller, car operating panel (COP), hall position indicators (HBP), and emergency & inspection panels (E&I).
4.Contractor to clarify the requirements for pit inspection reset switch and fireman service switch installations. (If any Contractor to Provide grounding and earthing details for elevator equipment, guide rails, and machine component.

Disclaimer :K&A Khatib Alami – Saudi Consolidated Engineering review and/or approval does not relieve the Contractor from obligation to adhere to Contract Documents. The Contractor remains fully responsible for the accuracy, completeness, coordination, and compliance of all submitted documents and works

CONTROLLED COPY
MBL IFC
JEDDAH OPERA HOUSE PROJECT
QA/QC Department
MBL QAM
Engr. Mudassar Altaf

dar Dar Al-Handasah consultants (Shair and Partners)
Checked and Reviewed

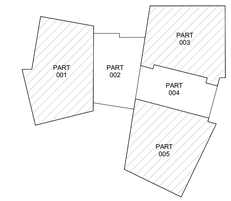

KEY PLAN

GENERAL NOTES: ALL LEVELS SHOWN ON THE DRAWING ARE CHART DATUM LEVELS PROJECT LEVEL+0.000 = +3.700 CHART DATUM

Refer to:
For Hooks design TQ-OPE-MBL-JCDC-00952
Electrical Panels distribution: JOH-ICD-S5-01-056-XXX-03-SD-EL-011630_1
wiring diagram opera lift
Acoustic Letter: L-OTIS-MBL-OPE-26-0015

DRAWING / DOCUMENT REFERENCE

NO.	NUMBER		TITLE	REV
01	L-03	L-04	JOH-HLA-S4-01-056-XXX-01-DR-AR-011110	F00
02			JOH-BHC-S4-01-056-XXX-XX-DR-VT-015001	
03			JOH-BHC-S4-01-056-XXX-XX-DR-VT-010001	
04			JOH-BHC-S4-01-056-005-ZZ-DR-VT-013001	
05			JOH-BHC-S4-01-056-005-ZZ-DR-VT-011001	
06			TQ-OPE-MBL-JCDC-00222	
07			TQ-OPE-MBL-JCDC-00952	
08			JCD-OPE-MBL-MR-003-NMR-601-03	
09			JCD-OPE-MBL-MR-003-NMR-602-01	
10			TQ-OPE-MBL-JCDC-01299	
11			TQ-OPE-MBL-JCDC-01308	

REVIEWED BY DISCIPLINE	SIGNATURE	DATE
ARCHITECTURAL	[illegible]	[illegible]
STRUCTURAL	[illegible]	2026-06-04
MECHANICAL	[illegible]	2026-06-04
PLUMBING	[illegible]	[illegible]
ELECTRICAL	[illegible]	[illegible]
ICT	[illegible]	2026-06-04
ADDITIONAL DISCIPLINES TO BE ADDED AS REQUIRED		

REV	DATE	BY	DESCRIPTION	CHK	APD
S00	31-MAY-2026	AK	Issued for Approval	SS	AB

DRAWING STATUS: CONSTRUCTION SHOPDRAWING

CLIENT: شركة وسط جدة للتطوير Jeddah Central Development Co.

LEAD DESIGN CONSULTANTS: Henning Larsen

LEAD ENGINEERING CONSULTANT: BURO HAPPOLD

PROJECT SUPERVISION CONSULTANT: K&A Khatib & Alami

GENERAL CONTRACTOR: MBL

REVIEWER: dar

SUB CONTRACTOR: OTIS ELEVATOR COMPANY (SAUDI ARABIA) LIMITED

PROJECT: JEDDAH OPERA HOUSE

TITLE: OPERA BUILDING
VERTICAL TRANSPORTATION
PART 002
SECTIONS - LIFT SHAFT (L03 & L04)

SCALE @ A1:	CHECKED:	APPROVED:
As indicated	SS	AB

PROJECT No:	DESIGNED:	DRAWN:	DATE:
440014	AK	PR	31-MAY-2026

DRAWING No: JOH-OTS-S5-01-056-002-ZZ-SD-VT-013010 REV: S00

MODEL FILE REF: JOH-OTS-S5-01-056-XXX-ZZ-M3-VT-010001

© JCDC