

Lift 07

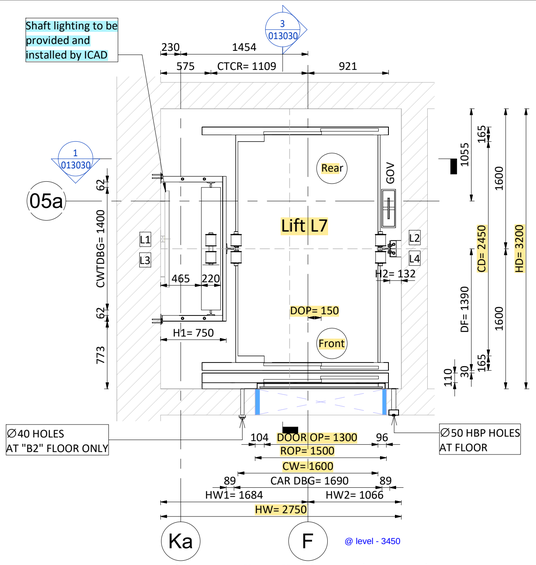


1 Hoist Way Plan At "B2" Floor (Front) - ELEV-L7

1 : 35

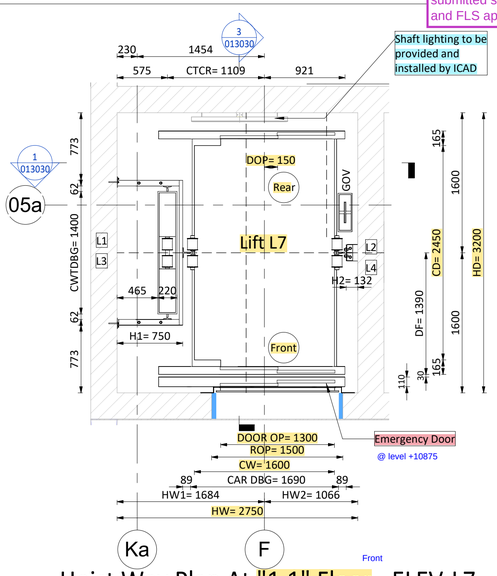


2 Hoist Way Plan At "1.1" Floor - ELEV-L7

1 : 35

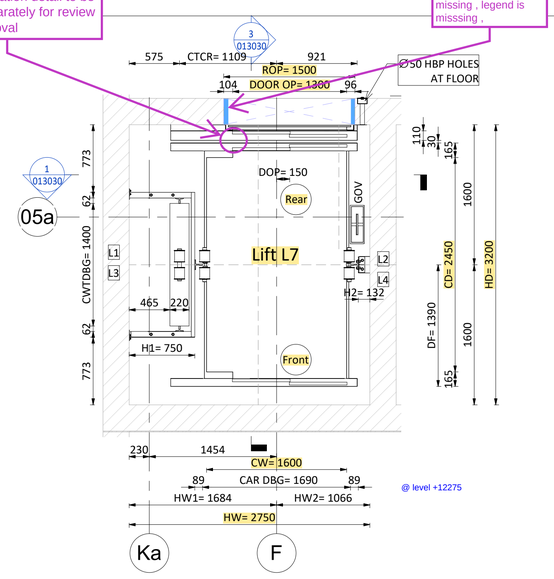


3 Hoist Way Plan At "1.2" Floor (Rear) - ELEV-L7

1 : 35

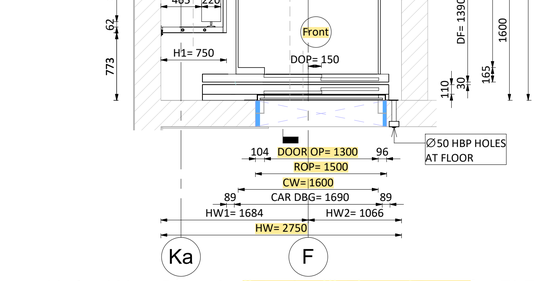


4 Hoist Way Plan At "Typical" Floor (Front) - ELEV-L7

1 : 35

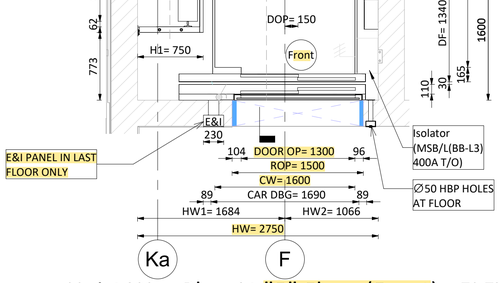


5 Hoist Way Plan At "5" Floor (Front) - ELEV-L7

1 : 35

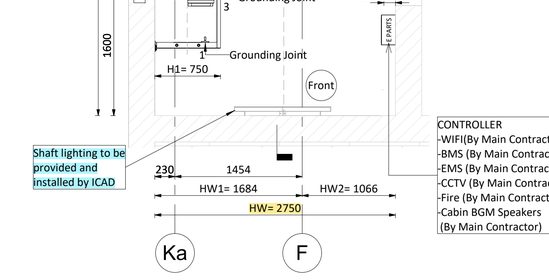


6 Machine Plan Level - ELEV-L7

1 : 35

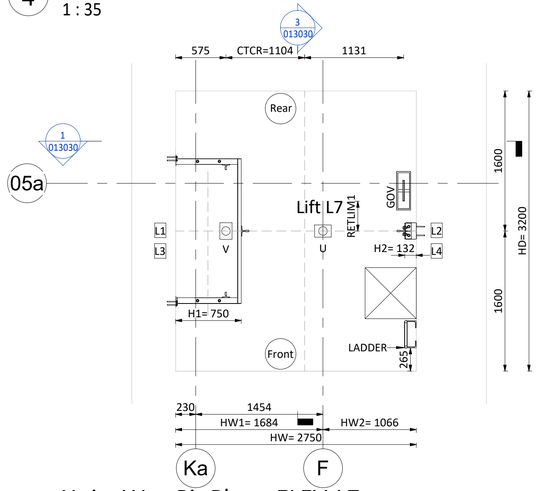

7 Hoist Way Pit Plan - ELEV-L7

1 : 35

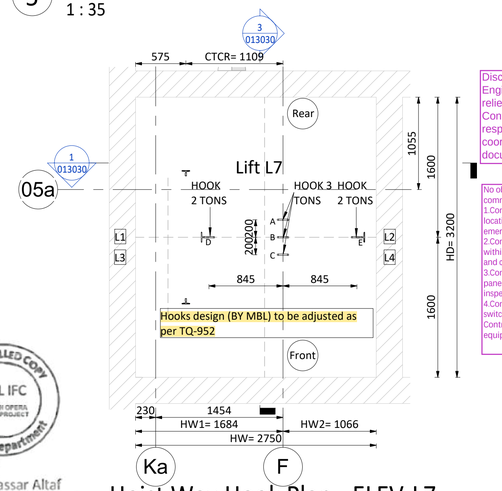

8 Hoist Way Hook Plan - ELEV-L7

1 : 35

CONTROLLED COPY
MBL IFC
JEDDAH OPERA HOUSE PROJECT
QA/QC Department
MBL QAM
Engr. Mudassar Altaf


Disclaimer :K&A Khatib Alami – Saudi Consolidated Engineering review and/or approval does not relieve the Contractor from obligation to adhere to Contract Documents. The Contractor remains fully responsible for the accuracy, completeness, coordination, and compliance of all submitted documents and works

No objection from Electrical side with the following general comments:
1.Contractor to clarify lighting supply requirements and provide locations and provisions for shaft lighting, cabin lighting, emergency lighting, and ventilation fans.
2.Contractor to confirm compatibility with other interfaced systems within the project: BMS, PMS, CCTV, Fire alarm system, Intercom, and cabin speakers as noted on drawings.
3.Contractor to submit wiring diagrams for controller, car operating panel (COP), hall position indicators (HBP), and emergency & inspection panels (E&I).
4.Contractor to clarify the requirements for pit inspection reset switch and fireman service switch installations. (If any Contractor to Provide grounding and earthing details for elevator equipment, guide rails, and machine component.


SCEC – K&A Reviewed
Civil
Arch.
Elec.
ELV.
Mech.
Acoustic

SCEC – K&A Reviewed
Code B – Approved with Comments (Do not Resubmit)

9-this note is rejected , it is contractor sole responsibility to submit a complete coordinated shop-drawing connection details with wall finishes ,architraves floor threshold connection and liner/top door connection

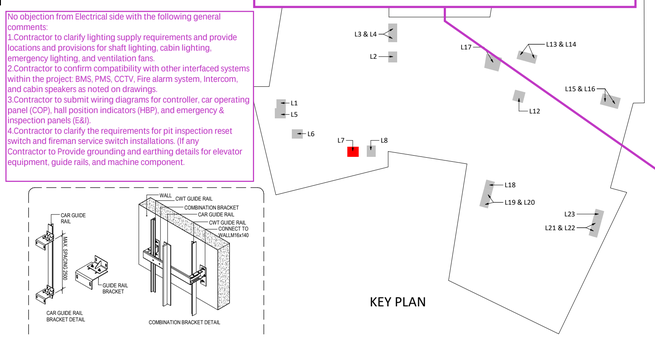

KEY PLAN

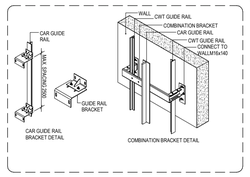


1-shaft size to be extracted from federated model
2-contractor must take in consideration as built dimensions and conditions prior execution
3- FFL Levels shall match the federated model levels and as per site conditions
4- Elevator Car Sizes/**dimensions** and Floors Being Served by the Elevators shall be as per approved TBE and further to OTIS letter **TQ-05809** and lift deviation letter ref:**TQ-OPE-MBL-JCDC-01330**
5- car interior finishes shall be submitted in a separate submission for approval
6-HOISTWAY PRESSURIZATION is not provided contractor shall confirm its requirement prior execution
7-Contractor to update the missing reference when submitting the coordination drawing with wall finishing
8-hoistway entrance to be verified by contractor by the contractor to align with OTIS proposed drawings
9-stair ladder shall be submitted separately for approval
Structural comments:
8-Structural design of brackets including their anchor bolts into the concrete walls for the lift loads is to be submitted for checking and approval.
Otherwise, evident for its adequacy is to be provided.

MBL to provide a comprehensive Method Statement describing the procedure for filling all gaps and correcting / adjusting the rough openings for doors

dar Bar Al Handasah consultants (Shair and Partners)
Checked and Reviewed

missing information and include only the related TQ

add the letter references TQ-05809 & deviation letter

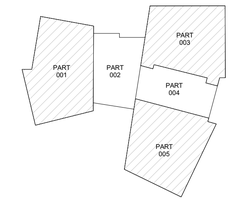

KEY PLAN

GENERAL NOTES: ALL LEVELS SHOWN ON THE DRAWING ARE CHART DATUM LEVELS PROJECT LEVEL+0.000 = +3.700 CHART DATUM.

Refer to:
For Hooks design TQ-OPE-MBL-JCDC-00952
For Electrical Panels distribution:
JOH-ICD-S5-01-056-001-04-SD-EL-011641
JOH-ICD-S5-01-056-XXX-04-SD-EL-011640
Attached wiring diagram opera lift
Attached Acoustic Letter: L-OTIS-MBL-OPE-26-0015

DRAWING / DOCUMENT REFERENCE

NO.	NUMBER	TITLE	REV
01	L17	JOH-HLA-S4-01-056-XXX-01-DR-AR-011110	S00
02		JOH-BHC-S4-01-056-XXX-XX-DR-VT-015001	
03		JOH-BHC-S4-01-056-XXX-XX-DR-VT-010001	
04		JOH-BHC-S4-01-056-005-ZZ-DR-VT-013001	
05		JOH-BHC-S4-01-056-005-ZZ-DR-VT-011001	
06		TQ-OPE-MBL-JCDC-00222	
07		TQ-OPE-MBL-JCDC-00952	
08		JCD-OPE-MBL-MR-003-NMR-601-03	
09		JCD-OPE-MBL-MR-003-NMR-602-01	

TOR GENERAL SPECIFICATIONS

LIFT NUMBER	ELEV.L7
CABIN INTERNAL SIZE(WXDXH)	1600X2450X2600
CAPACITY	
CLEAR ENTRANCE	
CONTROL	
CONTROL SYSTEM	CTIVE
COUNTERWEIGHT SAFETY	NO
DOOR TYPE	TLD2
EMERGENCY EXITS	1
FRONT OPENING	6
HEAT RELEASE	1774Kcal/h
HOISTWAY SIZE(HWXHD)	2750X3200
LIFT NUMBER	ELV.L7
LIGHTING SUPPLY	220V 60HZ
MIN.FLOOR HEIGHT	3000
NO. OF FLOOR	8
NO. OF OPENINGS	8
NO. OF UNITS	1
NON-STOP FLOORS	1
NON-STOP FLOORS NAMES	LEVEL-1
NUMBER OF PASSENGERS	26P
OVERHEAD	5740mm
PIT DEPTH	1500mm
POWER SUPPLY	380V 3P 60HZ
PRODUCT NO.	GeN2 MRL
RATED CURRENT(A)	31.4
REAR OPENING	1
ROPING	2:1
SPEED(m/s)	1.00
START CURRENT(A)	34.4
SYSTEM POWER(KW)	16.6
TRAVEL	27975mm
USE Technical	~~PASSENGER LIFT~~(Firefighting)

REACTIONS FORCE (KN)

Car side rail	CWT guide rail	Pit reaction
R= 91	R= 26	U= 188
R1= 4.24	R1= 1.76	V= 147
R2= 2.95	R2= 0.28	

LEGEND

HW	HOIST WAY WIDTH
HD	HOIST WAY DEPTH
CRH	CAR ROUGH HEIGHT
DOOR OP	DOOR OPENING
ROP	ROUGH OPENING
CW	CAR WIDTH
CD	CAR DEPTH
CH	CAR HEIGHT
DBG	DISTANCE BETWEEN GUARDRAIL
CWT	COUNTERWEIGHT
E&I PANEL	EMERGENCY & INSPECTION PANEL
G.O.V	CAR GOVERNOR
COP	CAR OPERATING PANEL
HBP	HALL POSITION INDICATOR
	CONCRETE
	BLOCK

NOTE NO.:
FRONT WALLS,FINISHES & ARCHITRAVES TO BE BUILT (BY CLIENT) AFTER THE INSTALLATION OF THE (LANDING) EXTERNAL DOORS.

IMPORTANT NOTE FOR MAIN CONTRACTOR.
FREEDOM OF ACCESS MUST BE AVAILABLE FOR POINT OF ENTRY INTO THE BUILDING UP TO THE ELEVATOR HOIST WAY AND THE FRONT WALLS OF THE HOIST WAY AT MAIN FLOOR TO BE LEFT OPEN FOR FULL WIDTH AND HEIGHT TO PERMIT ENTRY OF OUR EQUIPMENT.

REVIEWED BY DISCIPLINE	SIGNATURE	DATE
ARCHITECTURAL	MT	[illegible]
STRUCTURAL	PC	[illegible]
MECHANICAL	Sh.	[illegible]
PLUMBING	[illegible]	[illegible]
ELECTRICAL	Sh.A	2026-06-17
ICT	Sh.A	[illegible]
ADDITIONAL DISCIPLINES TO BE ADDED AS REQUIRED		

REV	DATE	BY	DESCRIPTION	CHK	APD
S00	31-MAY-2026	AK	Issued for Approval	SS	AB

DRAWING STATUS: CONSTRUCTION SHOPDRAWING

CLIENT: شركة وسط جدة للتطوير Jeddah Central Development Co.

LEAD DESIGN CONSULTANTS: Henning Larsen

LEAD ENGINEERING CONSULTANT: BURO HAPPOLD

PROJECT SUPERVISION CONSULTANT: K&A Khatib & Alami

GENERAL CONTRACTOR: MBL

REVIEWER: dar

SUB CONTRACTOR: OTIS

PROJECT: JEDDAH OPERA HOUSE

TITLE: OPERA BUILDING
VERTICAL TRANSPORTATION
PART 001
PLANS - LIFT SHAFT (L07)


SCALE @ A1:	CHECKED:	APPROVED:
As indicated	SS	AB

PROJECT No:	DESIGNED:	DRAWN:	DATE:
440014	AK	PR	31-MAY-2026

DRAWING No: JOH-OTS-S5-01-056-001-ZZ-SD-VT-011030 REV: S00


MODEL FILE REF: JOH-OTS-S5-01-056-XXX-ZZ-M3-VT-010001

© JCDC

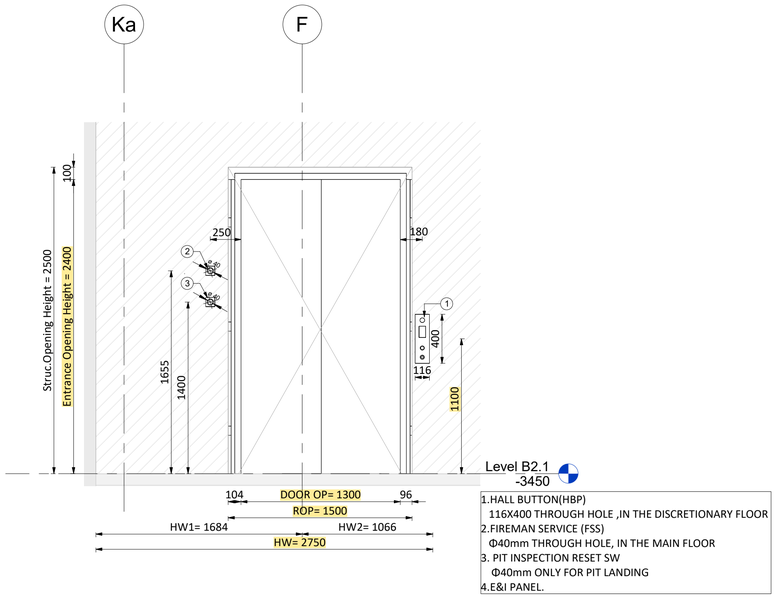


1 Door Elevation At "B2" Floor (Front) - ELEV-L7

1 : 25

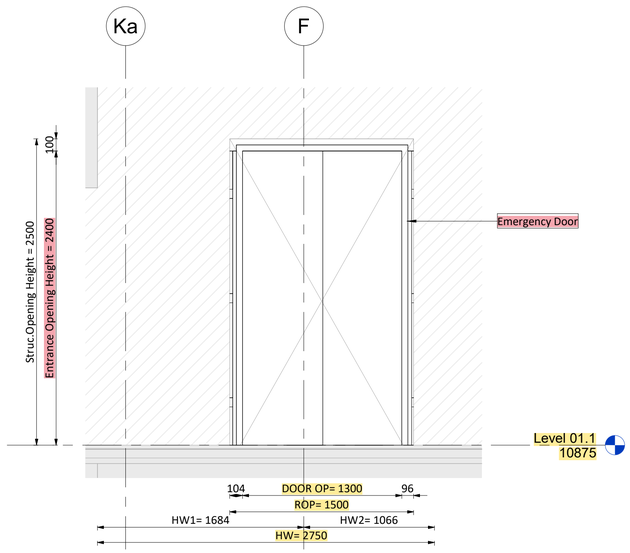


2 Door Elevation At "1.1" Floor (Front) - ELEV-L7

1 : 25

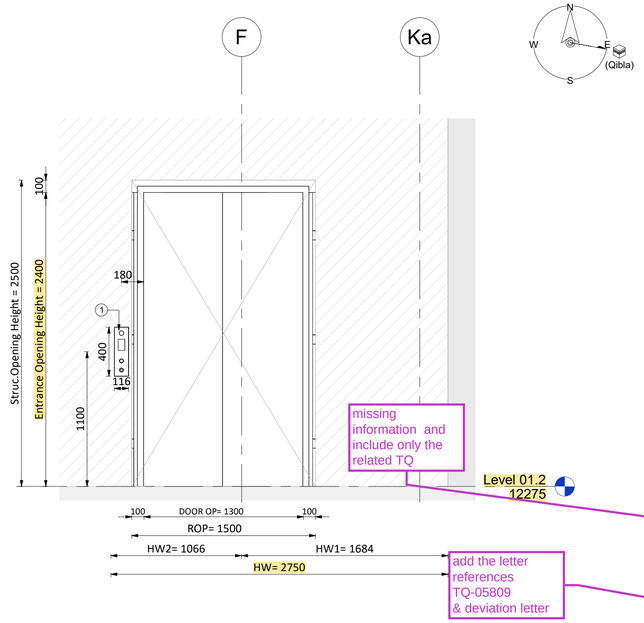

3 Door Elevation At "1.2" Floor (Rear) - ELEV-L7

1 : 25

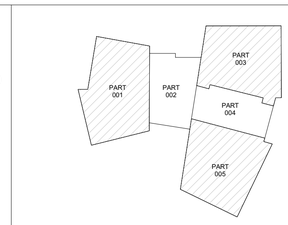

KEY PLAN

GENERAL NOTES: ALL LEVELS SHOWN ON THE DRAWING ARE CHART DATUM LEVELS PROJECT LEVEL+0.000 = +3.700 CHART DATUM.

Refer to:
For Hooks design TQ-OPE-MBL-JCDC-00952
For Electrical Panels distribution:
JOH-ICD-S5-01-056-001-04-SD-EL-011641
JOH-ICD-S5-01-056-XXX-04-SD-EL-011640
Attached wiring diagram opera lift
Attached Acoustic Letter: L-OTIS-MBL-OPE-26-0015

DRAWING / DOCUMENT REFERENCE

NO.	NUMBER	TITLE	REV
01	L-07	JOH-HLA-S4-01-056-XXX-01-DR-AR-011110	S00
02		JOH-BHC-S4-01-056-XXX-XX-DR-VT-015001	
03		JOH-BHC-S4-01-056-XXX-XX-DR-VT-010001	
04		JOH-BHC-S4-01-056-005-ZZ-DR-VT-013001	
05		JOH-BHC-S4-01-056-005-ZZ-DR-VT-011001	
06		TQ-OPE-MBL-JCDC-00222	
07		TQ-OPE-MBL-JCDC-00952	
08		JCD-OPE-MBL-MR-003-NMR-601-03	
09		JCD-OPE-MBL-MR-003-NMR-602-01	


REVIEWED BY DISCIPLINE	SIGNATURE	DATE
ARCHITECTURAL	MT	[illegible]
STRUCTURAL	PC	2026-06-17
MECHANICAL	Sh.	[illegible] 16-17
PLUMBING	[illegible]	[illegible]
ELECTRICAL	Sh.A	2026-06-17
ICT	Sh.A	[illegible]
ADDITIONAL DISCIPLINES TO BE ADDED AS REQUIRED		

REV	DATE	BY	DESCRIPTION	CHK	APD
S00	31-MAY-2026	AK	Issued for Approval	SS	AB

1-shaft size to be extracted from federated model
2-contractor must take in consideration as built dimensions and conditions prior execution
3- FFL Levels shall match the federated model levels and as per site conditions
4- Elevator Car Sizes/**dimensions** and Floors Being Served by the Elevators shall be as per approved TBE and further to OTIS letter **TQ-05809** and lift deviation letter ref:**TQ-OPE-MBL-JCDC-01330**
5- car interior finishes shall be submitted in a separate submission for approval
6-HOISTWAY PRESSURIZATION is not provided contractor shall confirm its requirement prior execution
7-Contractor to update the missing reference when submitting the coordination drawing with wall finishing
8-hoistway entrance to be verified by contractor by the contractor to align with OTIS proposed drawings
9-stair ladder shall be submitted separately for approval
Structural comments:
8-Structural design of brackets including their anchor bolts into the concrete walls for the lift loads is to be submitted for checking and approval.
Otherwise, evident for its adequacy is to be provided.


Disclaimer :K&A Khatib Alami – Saudi Consolidated Engineering review and/or approval does not relieve the Contractor from obligation to adhere to Contract Documents. The Contractor remains fully responsible for the accuracy, completeness, coordination, and compliance of all submitted documents and works

No objection from Electrical side with the following general comments:
1.Contractor to clarify lighting supply requirements and provide locations and provisions for shaft lighting, cabin lighting, emergency lighting, and ventilation fans.
2.Contractor to confirm compatibility with other interfaced systems within the project: BMS, PMS, CCTV, Fire alarm system, Intercom, and cabin speakers as noted on drawings.
3.Contractor to submit wiring diagrams for controller, car operating panel (COP), hall position indicators (HBP), and emergency & inspection panels (E&I).
4.Contractor to clarify the requirements for pit inspection reset switch and fireman service switch installations. (If any Contractor to Provide grounding and earthing details for elevator equipment, guide rails, and machine component.

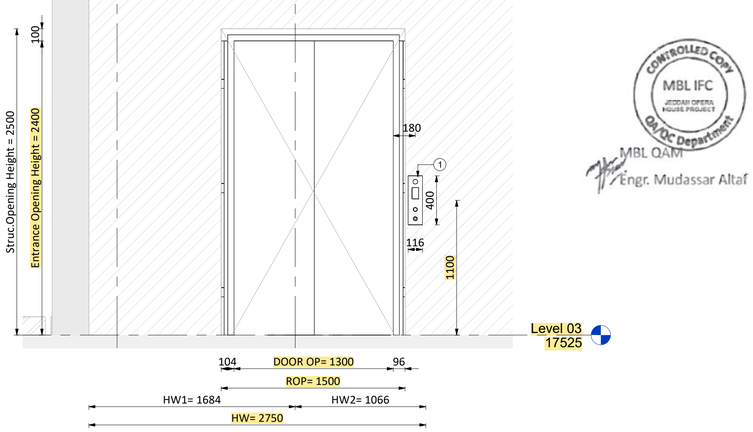

4 Door Elevation At "Typical" Floor (Front) - ELEV-L7

1 : 25

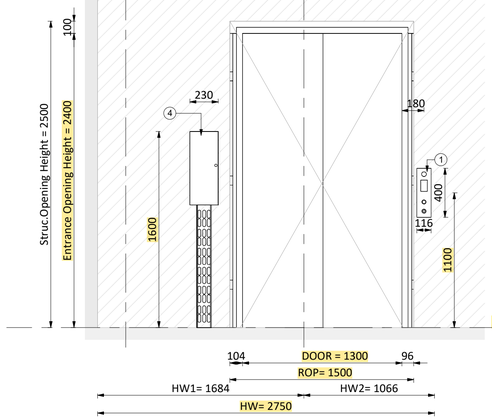


5 Door Elevation At "Top" Floor (Front) - ELEV-L7

1 : 25

MBL to provide a comprehensive Method Statement describing the procedure for filling all gaps and correcting / adjusting the rough openings for doors


dar Dar Al Handasah consultants (Shair and Partners)
Checked and Reviewed

SCEC – K&A Reviewed
Code B – Approved with Comments
(Do not Resubmit)

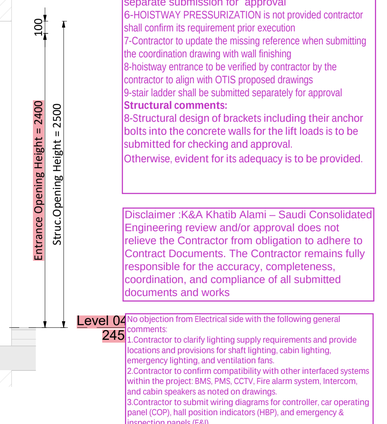


6 Cross-Section View A-A - E

1 : 25

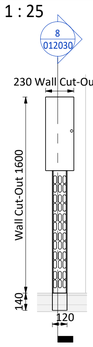


7 E&I SPOT DETAIL - ELEV-L7

1 : 25

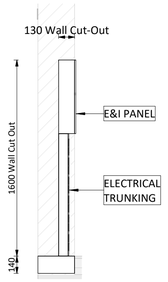


8 Cross-Section View B-B - ELEV-L7

1 : 25

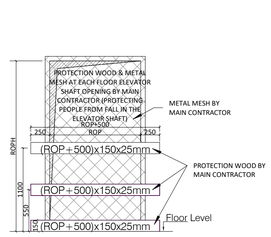

Protection Elevation Detail
At Each Elevator Shaft Opening

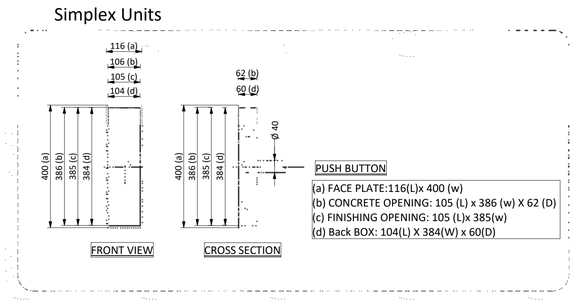

LEGEND	
HW	HOIST WAY WIDTH
HD	HOIST WAY DEPTH
CRH	CAR ROUGH HEIGHT
DOOR OP	DOOR OPENING
ROP	ROUGH OPENING
CW	CAR WIDTH
CD	CAR DEPTH
CH	CAR HEIGHT
DBG	DISTANCE BETWEEN GUARDRAIL
CWT	COUNTERWEIGHT
E&I PANEL	EMERGENCY & INSPECTION PANEL
G.O.V	CAR GOVERNOR
COP	CAR OPERATING PANEL
HBP	HALL BUTTON POSITION INDICATOR

DRAWING STATUS: CONSTRUCTION SHOPDRAWING

CLIENT: شركة جدة للتطوير Jeddah Central Development Co.

LEAD DESIGN CONSULTANTS: Henning Larsen

LEAD ENGINEERING CONSULTANT: BURO HAPPOLD

PROJECT SUPERVISION CONSULTANT: K&A

GENERAL CONTRACTOR: MBL

REVIEWER: dar

SUB CONTRACTOR: OTIS ELEVATOR COMPANY SAUDI ARABIA LIMITED

PROJECT: JEDDAH OPERA HOUSE

TITLE: OPERA BUILDING
VERTICAL TRANSPORTATION
PART 001
ELEVATIONS - LIFT SHAFT (L07)


SCALE @ A1:	CHECKED:	APPROVED:
As indicated	SS	AB

PROJECT No:	DESIGNED:	DRAWN:	DATE:
440014	AK	PR	31-MAY-2026

DRAWING No: JOH-OTS-S5-01-056-001-ZZ-SD-VT-012030 REV: S00


MODEL FILE REF: JOH-OTS-S5-01-056-XXX-ZZ-M3-VT-010001

© JCDC

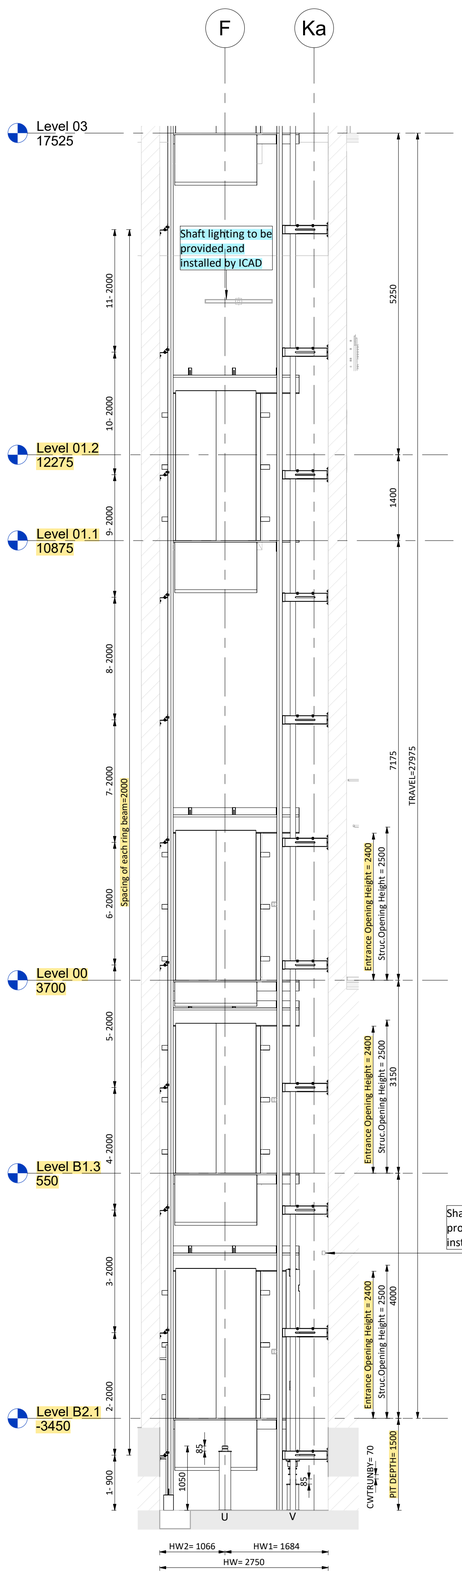


1 Section "A" - ELEV-L7

1 : 50

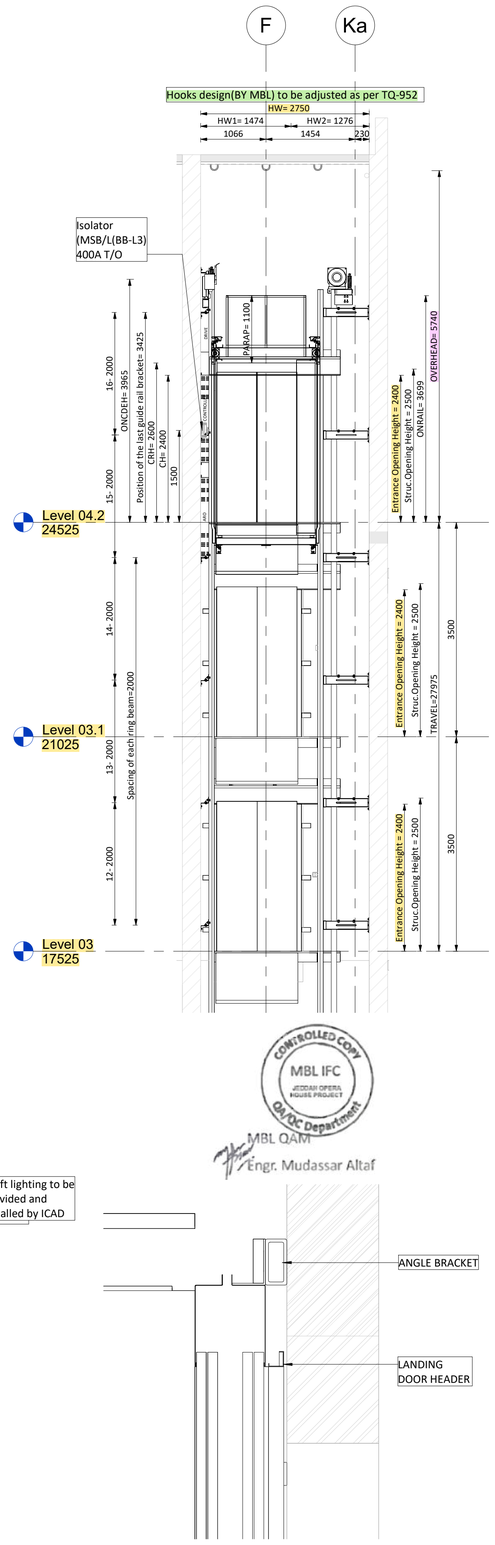


2 Landing Door Header Detail - ELEV-L7

1 : 10

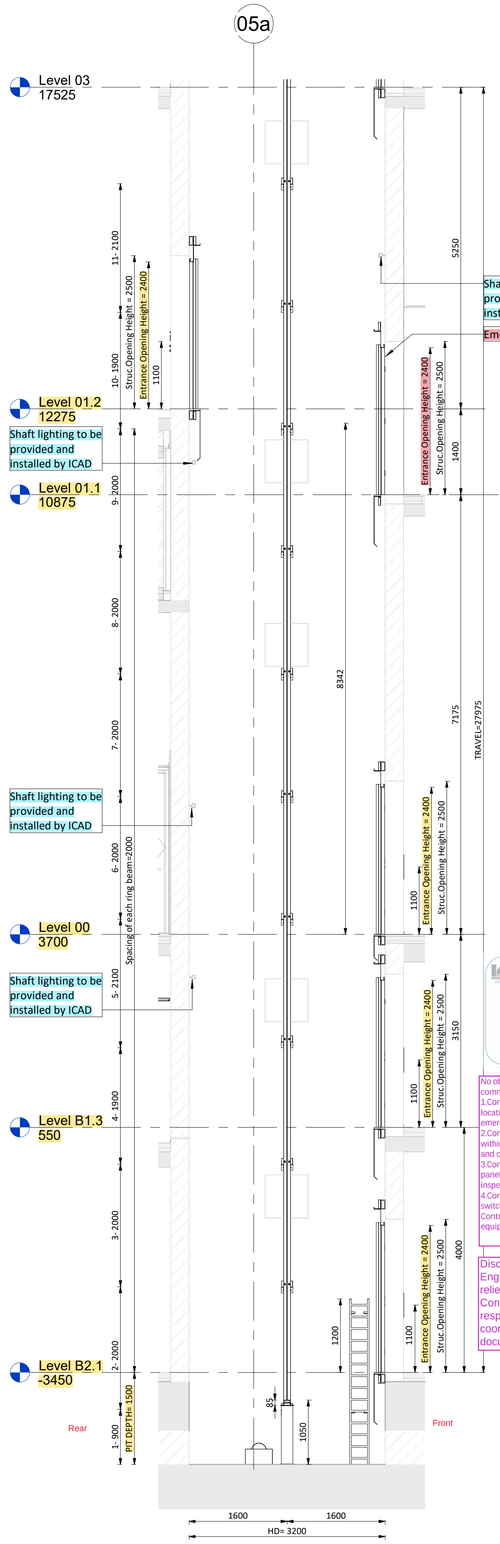


3 Section "B" - ELEV-L7

1 : 50

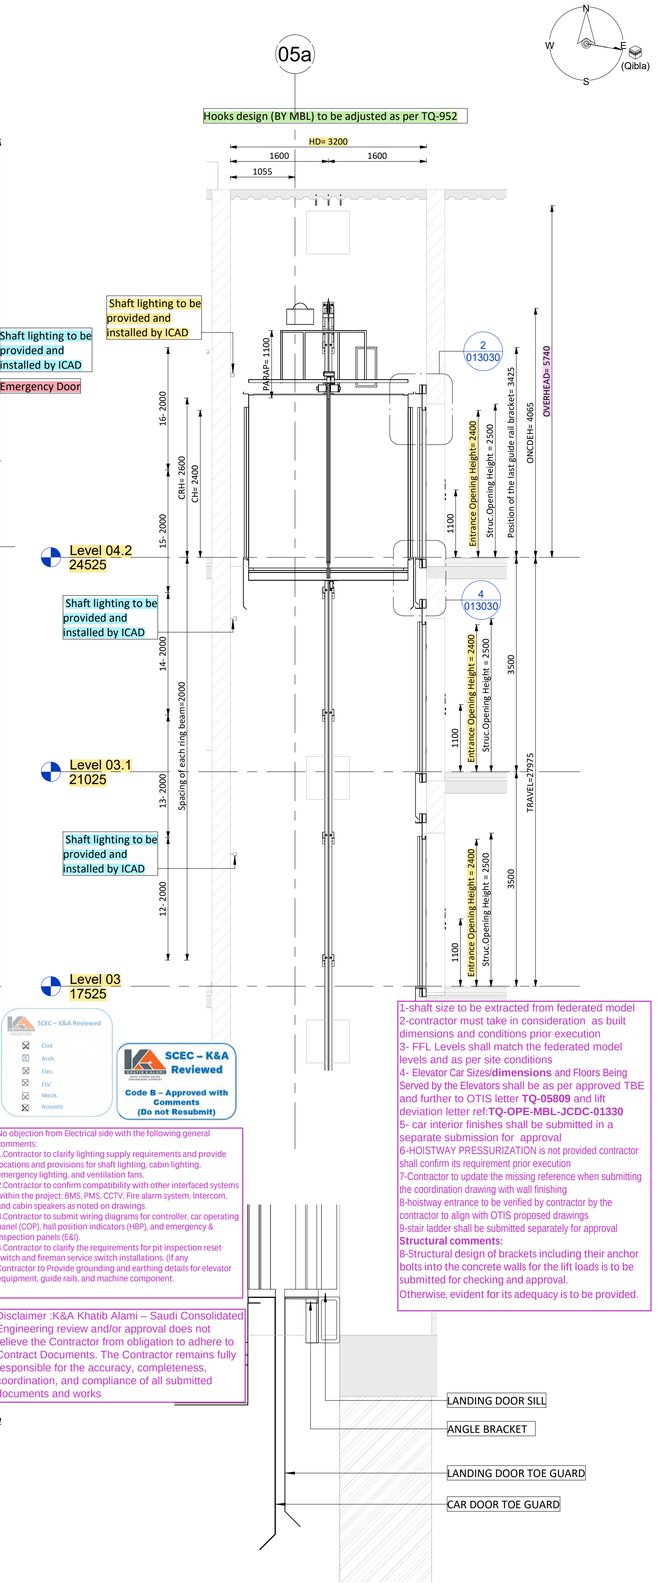

4 Landing Door Bottom Detail - ELEV-L7

1 : 10

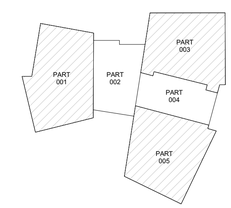

KEY PLAN

GENERAL NOTES: ALL LEVELS SHOWN ON THE DRAWING ARE CHART DATUM LEVELS PROJECT LEVEL+0.000 = +3.700 CHART DATUM.

Refer to:
For Hooks design TQ-OPE-MBL-JCDC-00952
For Electrical Panels distribution:
JOH-ICD-S5-01-056-001-04-SD-EL-011641
JOH-ICD-S5-01-056-XXX-04-SD-EL-011640
Attached wiring diagram opera lift
Attached Acoustic Letter: L-OTIS-MBL-OPE-26-0015

DRAWING / DOCUMENT REFERENCE

NO.	NUMBER	TITLE	REV.
01	L-07	JOH-HLA-S4-01-056-XXX-01-DR-AR-011110	S00
02		JOH-BHC-S4-01-056-XXX-XX-DR-VT-015001	
03		JOH-BHC-S4-01-056-XXX-XX-DR-VT-010001	
04		JOH-BHC-S4-01-056-005-ZZ-DR-VT-013001	
05		JOH-BHC-S4-01-056-005-ZZ-DR-VT-011001	
06		TQ-OPE-MBL-JCDC-00222	
07		TQ-OPE-MBL-JCDC-00952	
08		JCD-OPE-MBL-MR-003-NMR-601-03	
09		JCD-OPE-MBL-MR-003-NMR-602-01	

REVIEWED BY DISCIPLINE	SIGNATURE	DATE
ARCHITECTURAL	MT	2026-06-17
STRUCTURAL	PC	2026-06-17
MECHANICAL	Sh.	2026-06-17
PLUMBING	Sh.A	2026-06-17
ELECTRICAL	Sh.A	2026-06-17
ICT	Sh.A	2026-06-17
ADDITIONAL DISCIPLINES TO BE ADDED AS REQUIRED		

REV	DATE	BY	DESCRIPTION	CHK	APD
S00	31-MAY-2026	AK	Issued for Approval	SS	AB

SCEC – K&A Reviewed
Civil
Arch.
Elec.
ELV.
Mech.
Acoustic

SCEC – K&A Reviewed
Code B – Approved with Comments
(Do not Resubmit)

No objection from Electrical side with the following general comments:
1.Contractor to clarify lighting supply requirements and provide locations and provisions for shaft lighting, cabin lighting, emergency lighting, and ventilation fans.
2.Contractor to confirm compatibility with other interfaced systems within the project: BMS, PMS, CCTV, Fire alarm system, Intercom, and cabin speakers as noted on drawings.
3.Contractor to submit wiring diagrams for controller, car operating panel (COP), hall position indicators (HBP), and emergency & inspection panels (E&I).
4.Contractor to clarify the requirements for pit inspection reset switch and fireman service switch installations. (If any Contractor to Provide grounding and earthing details for elevator equipment, guide rails, and machine component.

Disclaimer :K&A Khatib Alami – Saudi Consolidated Engineering review and/or approval does not relieve the Contractor from obligation to adhere to Contract Documents. The Contractor remains fully responsible for the accuracy, completeness, coordination, and compliance of all submitted documents and works

1-shaft size to be extracted from federated model
2-contractor must take in consideration as built dimensions and conditions prior execution
3- FFL Levels shall match the federated model levels and as per site conditions
4- Elevator Car Sizes/**dimensions** and Floors Being Served by the Elevators shall be as per approved TBE and further to OTIS letter **TQ-05809** and lift deviation letter ref:**TQ-OPE-MBL-JCDC-01330**
5- car interior finishes shall be submitted in a separate submission for approval
6-HOISTWAY PRESSURIZATION is not provided contractor shall confirm its requirement prior execution
7-Contractor to update the missing reference when submitting the coordination drawing with wall finishing
8-hoistway entrance to be verified by contractor by the contractor to align with OTIS proposed drawings
9-stair ladder shall be submitted separately for approval
Structural comments:
8-Structural design of brackets including their anchor bolts into the concrete walls for the lift loads is to be submitted for checking and approval.
Otherwise, evident for its adequacy is to be provided.

Dar Al Handasah consultants (Shair and Partners)
Checked and Reviewed

DRAWING STATUS:
CONSTRUCTION SHOPDRAWING

CLIENT:
شركة وسط جدة للتطوير
Jeddah Central Development Co.

LEAD DESIGN CONSULTANTS:
Henning Larsen

LEAD ENGINEERING CONSULTANT:
BURO HAPPOLD

PROJECT SUPERVISION CONSULTANT:
K.A. KHATIB & ALAMI

GENERAL CONTRACTOR:
MBL

REVIEWER:
dar

SUB CONTRACTOR:
OTIS ELEVATOR COMPANY SAUDI ARABIA LIMITED
OTIS

PROJECT
JEDDAH OPERA HOUSE

TITLE:
OPERA BUILDING
VERTICAL TRANSPORTATION
PART 001
SECTIONS - LIFT SHAFT (L07)

SCALE @ A1:	CHECKED:	APPROVED:
As indicated	SS	AB

PROJECT No:	DESIGNED:	DRAWN:	DATE:
440014	AK	PR	31-MAY-2026

DRAWING No: JOH-OTS-S5-01-056-001-ZZ-SD-VT-013030
REV: S00

MODEL FILE REF:
JOH-OTS-S5-01-056-XXX-ZZ-M3-VT-010001

© JCDC