

Lift 12

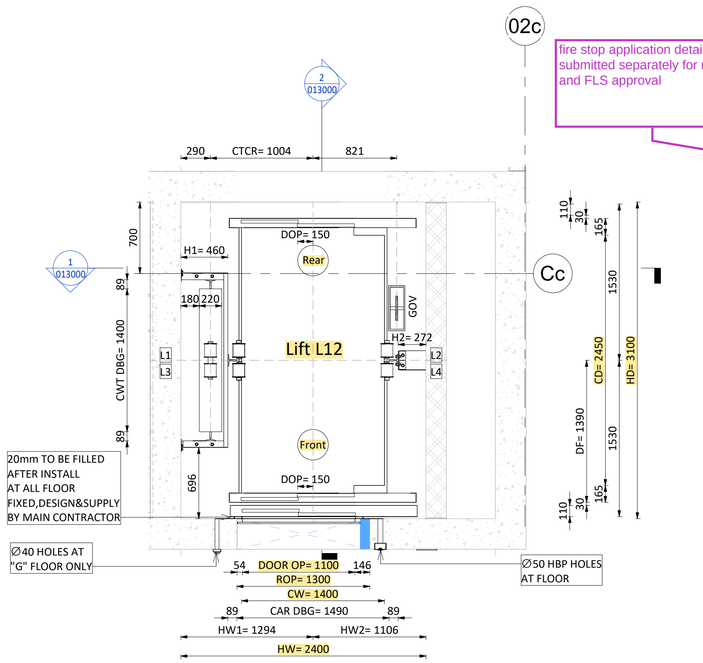

fire stop application detail to be submitted separately for review and FLS approval

1 Hoist Way Plan At "B2, G, 1" Floor (Front) - ELEV-L12


1 : 30

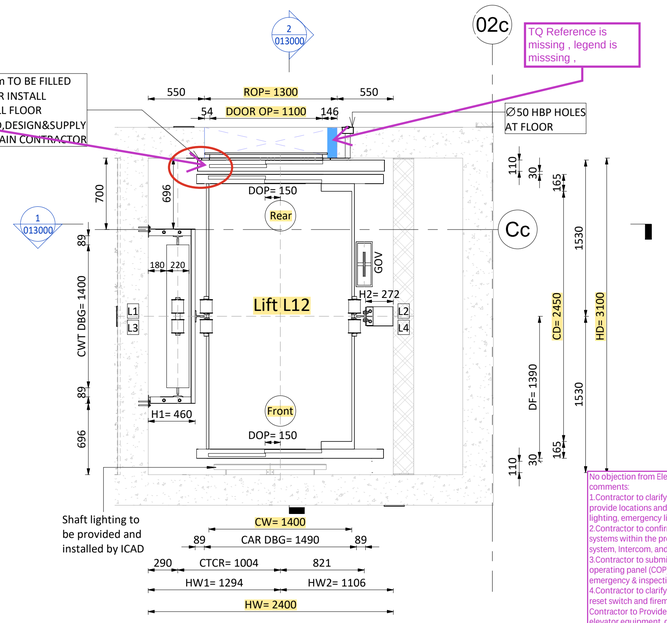


TQ Reference is missing , legend is misssing ,

2 Hoist Way Plan At "B1, 2, 4,5" Floor (Rear) - ELEV-L12


1 : 30

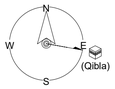

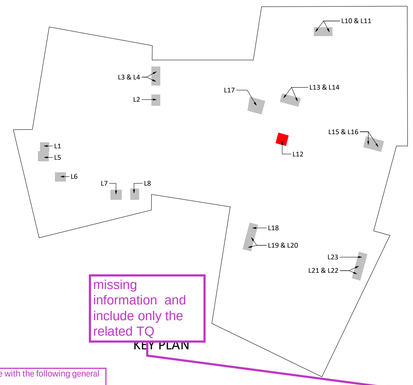

missing information and include only the related TQ

KEY PLAN

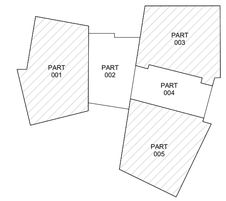

KEY PLAN

GENERAL NOTES: ALL LEVELS SHOWN ON THE DRAWING ARE CHART DATUM LEVELS PROJECT LEVEL+0.000 = +3.700 CHART DATUM.

Refer to :
LIFTS overhead steel hook beams structural calculation and fixation details: TR-OPE-MBL-JCDC-05193-S01
Electrical Panels distribution: JOH-ICD-S5-01-056-XXX-03-SD-EL-011630_1
wiring diagram opera lift
Acoustic Letter: L-OTIS-MBL-OPE-26-0015

No objection from Electrical side with the following general comments:
1.Contractor to clarify lighting supply requirements and provide locations and provisions for shaft lighting, cabin lighting, emergency lighting, and ventilation fans.
2.Contractor to confirm compatibility with other interfaced systems within the project: BMS, PMS, CCTV, Fire alarm system, Intercom, and cabin speakers as noted on drawings.
3.Contractor to submit wiring diagrams for controller, car operating panel (COP), hall position indicators (HBP), and emergency & inspection panels (E&I).
4.Contractor to clarify the requirements for pit inspection reset switch and fireman service switch installations. (If any Contractor to Provide grounding and earthing details for elevator equipment, guide rails, and machine component.

DRAWING / DOCUMENT REFERENCE

NO.	NUMBER	TITLE	REV
01	L-2	JOH-HLA-S4-01-056-XXX-02-DR-AR-011120	F00
02		JOH-BHC-S4-01-056-XXX-XX-DR-VT-015001	
03		JOH-BHC-S4-01-056-XXX-XX-DR-VT-010001	
04		JOH-BHC-S4-01-056-005-ZZ-DR-VT-013001	
05		JOH-BHC-S4-01-056-005-ZZ-DR-VT-011001	
06		TQ-OPE-MBL-JCDC-00222	
07		JCD-OPE-MBL-MR-003-NMR-601-03	
08		JCD-OPE-MBL-MR-003-NMR-602-01	
09		TR-OPE-MBL-JCDC-05193-01	
10		TQ-OPE-MBL-JCDC-01287	


add the letter references TQ-05809 & deviation letter

ELEV-L12 ELEVATOR GENERAL SPECIFICATIONS

LIFT NUMBER	ELEV.L12
CABIN INTERNAL SIZE(WXDXH)	1400x2450x2600
CAPACITY	1800 Kg
CLEAR ENTRANCE	1100X2400
CONTROL	VVVF
CONTROL SYSTEM	SIMPLEX FULL COLLECTIVE
COUNTERWEIGHT SAFETY	NO
DOOR TYPE	TLD2
EMERGENCY EXITS	-
FRONT OPENING	5
HEAT RELEASE	1774Kcal/h
HOISTWAY SIZE(HWXHD)	2400X3100
LIFT NUMBER	ELV.L12
LIGHTING SUPPLY	220V 60HZ
MIN.FLOOR HEIGHT	3000
NO. OF FLOOR	10
NO. OF OPENINGS	11
NO. OF UNITS	1
NON-STOP FLOORS	-
NON-STOP FLOORS NAMES	-
NUMBER OF PASSENGERS	24P
OVERHEAD	5400mm
PIT DEPTH	1600mm
POWER SUPPLY	380V 3P 60HZ
PRODUCT NO.	GeN2 MRL
RATED CURRENT(A)	31.4
REAR OPENING	6
ROPING	2:1
SPEED(m/s)	1.00
START CURRENT(A)	34.4
SYSTEM POWER(KW)	16.6
TRAVEL	34850mm
USE	~~PASSENGER LIFT~~ Technical


REACTIONS FORCE (KN)

Car side rail	CWT guide rail	Pit reaction
R= 86	R= 25	U= 174
R1= 3.84	R1= 1.65	V= 137
R2= 2.67	R2= 0.26	

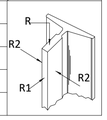


LEGEND

HW	HOIST WAY WIDTH
HD	HOIST WAY DEPTH
CRH	CAR ROUGH HEIGHT
DOOR OP	DOOR OPENING
ROP	ROUGH OPENING
CW	CAR WIDTH
CD	CAR DEPTH
CH	CAR HEIGHT
DBG	DISTANCE BETWEEN GUARDRAIL
CWT	COUNTERWEIGHT
E&I PANEL	EMERGENCY & INSPECTION PANEL
G.O.V	CAR GOVERNOR
COP	CAR OPERATING PANEL
HBP	HALL BUTTON POSITION INDICATOR

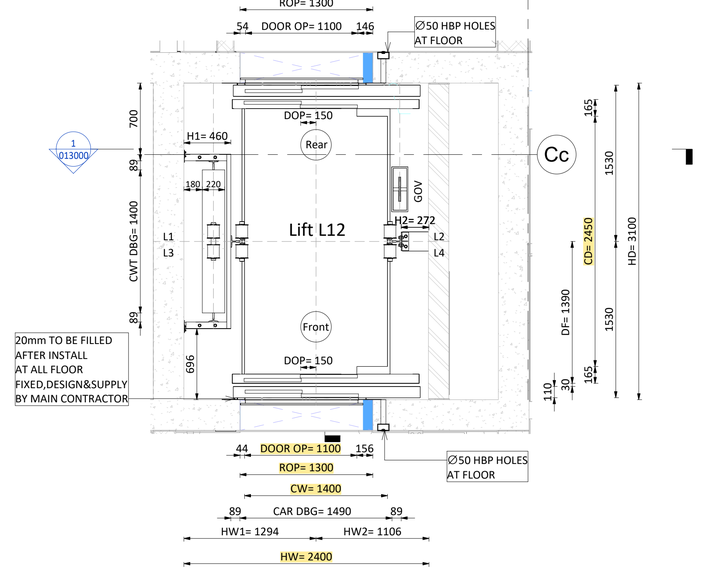

3 Hoist Way Plan At "3" Floor (Front & Rear) - ELEV-L12

1 : 30

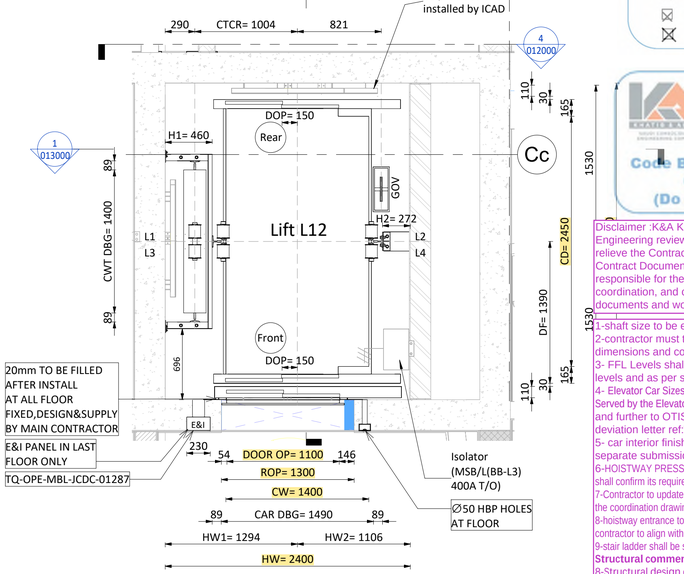

4 Hoist Way Plan At "6" Floor (Front) - ELEV-L12

1 : 30

SCEC – K&A Reviewed

Civil
Arch.
Elec.
ELV.
Mech.
Acoustic

SCEC – K&A Reviewed
Code B – Approved with Comments (Do not Resubmit)


Disclaimer :K&A Khatib Alami – Saudi Consolidated Engineering review and/or approval does not relieve the Contractor from obligation to adhere to Contract Documents. The Contractor remains fully responsible for the accuracy, completeness, coordination, and compliance of all submitted documents and works

1-shaft size to be extracted from federated model
2-contractor must take in consideration as built dimensions and conditions prior execution
3- FFL Levels shall match the federated model levels and as per site conditions
4- Elevator Car Sizes/**dimensions** and Floors Being Served by the Elevators shall be as per approved TBE and further to OTIS letter **TQ-05809** and lift deviation letter ref:**TQ-OPE-MBL-JCDC-01330**
5- car interior finishes shall be submitted in a separate submission for approval
6-HOISTWAY PRESSURIZATION is not provided contractor shall confirm its requirement prior execution
7-Contractor to update the missing reference when submitting the coordination drawing with wall finishing
8-hoistway entrance to be verified by contractor by the contractor to align with OTIS proposed drawings
9-stair ladder shall be submitted separately for approval
Structural comments:
8-Structural design of brackets including their anchor bolts into the concrete walls for the lift loads is to be submitted for checking and approval.
Otherwise, evident for its adequacy is to be provided.

9-this note is rejected , it is contractor sole responsibility to submit a complete coordinated shop-drawing connection details with wall finishes ,architraves floor threshold connection and linter/top door connection

NOTE No.:
FRONT WALLS FINISHES & ARCHITRAVES TO BE BUILT (BY CLIENT) AFTER THE INSTALLATION OF THE (LANDING) EXTERNAL DOORS.

IMPORTANT NOTE FOR MAIN CONTRACTOR.
FREEDOM OF ACCESS MUST BE AVAILABLE FOR POINT OF ENTRY INTO THE BUILDING UP TO THE ELEVATOR HOIST WAY AND THE FRONT WALLS OF THE HOIST WAY AT MAIN FLOOR TO BE LEFT OPEN FOR FULL WIDTH AND HEIGHT TO PERMIT ENTRY OF OUR EQUIPMENT.

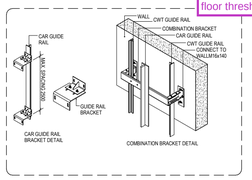

CONTROLLED COPY
MBL IFC
JEDDAH OPERA HOUSE PROJECT
QA/QC Department
MBL QAM
Engr. Mudassar Altaf

MBL to provide a comprehensive Method Statement describing the procedure for filling all gaps and correcting / adjusting the rough openings for doors.

dar Dar Al-Handasah consultants (Shair and Partners)
Checked and Reviewed

REVIEWED BY DISCIPLINE

	SIGNATURE	DATE
ARCHITECTURAL	[illegible]	[illegible]
STRUCTURAL	[illegible]	[illegible]
MECHANICAL	[illegible]	[illegible]
PLUMBING	[illegible]	[illegible]
ELECTRICAL	[illegible]	2026-06-03
ICT	[illegible]	2026-**-0*
ADDITIONAL DISCIPLINES TO BE ADDED AS REQUIRED		

REV	DATE	BY	DESCRIPTION	CHK	APD
S00	15-MAY-2026	AK	Issued for Approval	SS	AB

DRAWING STATUS:
CONSTRUCTION SHOPDRAWING

CLIENT: شركة وسط جدة للتطوير Jeddah Central Development Co.

LEAD DESIGN CONSULTANTS: Henning Larsen

LEAD ENGINEERING CONSULTANT: BURO HAPPOLD

PROJECT SUPERVISION CONSULTANT: KHATIB & ALAMI

GENERAL CONTRACTOR: MBL

REVIEWER: dar

SUB CONTRACTOR: OTIS ELEVATOR COMPANY SAUDI ARABIA LIMITED

PROJECT: JEDDAH OPERA HOUSE

TITLE:
OPERA BUILDING
VERTICAL TRANSPORTATION
PART 004
PLANS - LIFT SHAFT SHEET 01 OF 02 (L12)


SCALE @ A1:	CHECKED:	APPROVED:
As indicated	SS	AB

PROJECT No:	DESIGNED:	DRAWN:	DATE:
440014	AK	PR	15-MAY-2026

DRAWING No: JOH-OTS-S5-01-056-004-ZZ-SD-VT-011000 REV: S00


MODEL FILE REF: JOH-OTS-S5-01-056-XXX-ZZ-M3-VT-010001

© JCDC

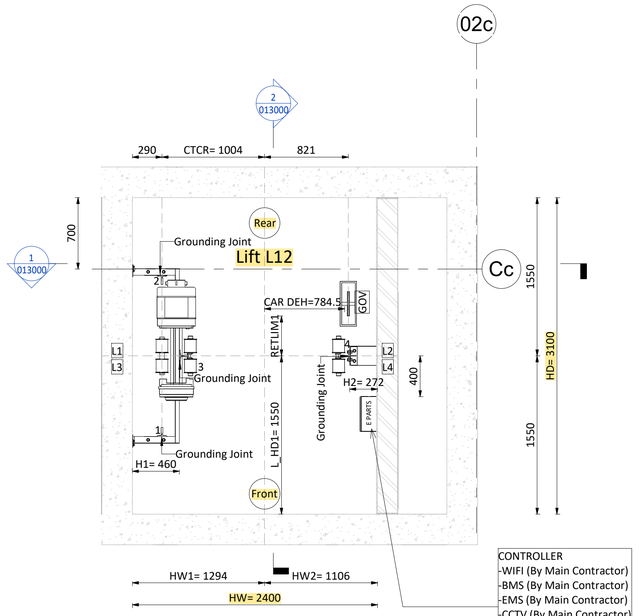


CONTROLLER
-WIFI (By Main Contractor)
-BMS (By Main Contractor)
-EMS (By Main Contractor)
-CCTV (By Main Contractor)
-Fire (By Main Contractor)
-Cabin BGM Speakers
(By Main Contractor)

1 Machine Plan Level - ELEV-L12
1 : 30

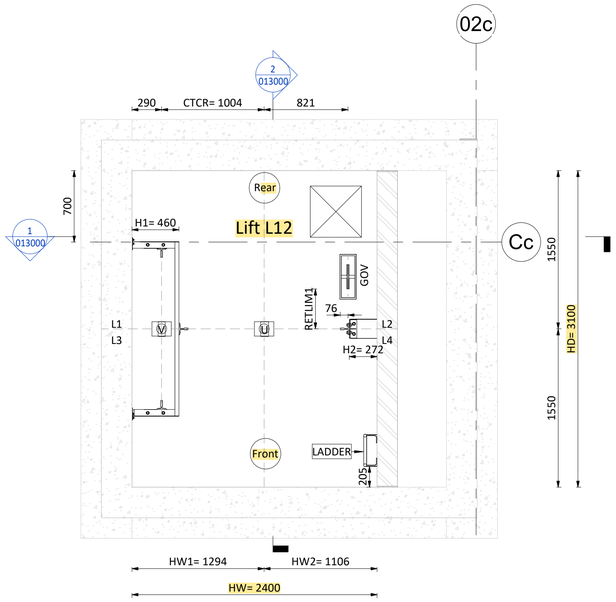



2 Hoist Way Pit Plan - ELEV-L12
1 : 30

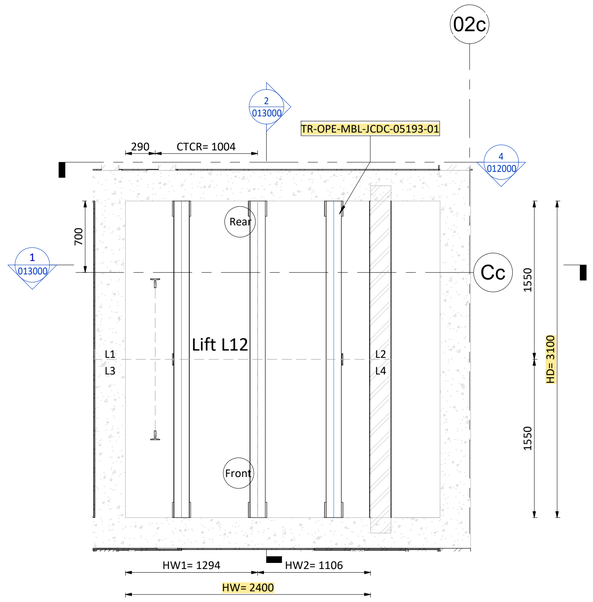

3 Hoist Way Hook Plan - ELEV-L12
1 : 30

No objection from Electrical side with the following general comments:
1.Contractor to clarify lighting supply requirements and provide locations and provisions for shaft lighting, cabin lighting, emergency lighting, and ventilation fans.
2.Contractor to confirm compatibility with other interfaced systems within the project: BMS, PMS, CCTV, Fire alarm system, Intercom, and cabin speakers as noted on drawings.
3.Contractor to submit wiring diagrams for controller, car operating panel (COP), hall position indicators (HBP), and emergency & inspection panels (E&I).
4.Contractor to clarify the requirements for pit inspection reset switch and fireman service switch installations. (If any Contractor to Provide grounding and earthing details for elevator equipment, guide rails, and machine component.

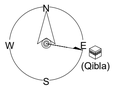


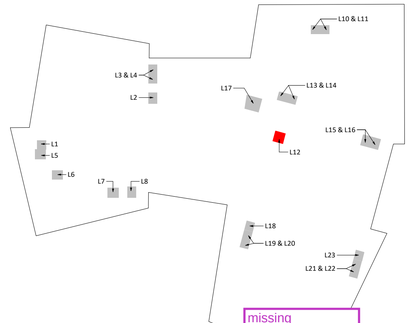

KEY PLAN

missing information and include only the related TQ

add the letter references TQ-05809 & deviation letter

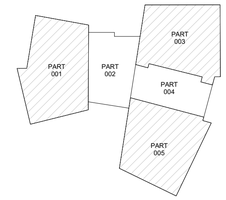

KEY PLAN

GENERAL NOTES: ALL LEVELS SHOWN ON THE DRAWING ARE CHART DATUM LEVELS PROJECT LEVEL+0.000 = +3.700 CHART DATUM.

Refer to :
LIFTS overhead steel hook beams structural calculation and fixation details: TR-OPE-MBL-JCDC-05193-S01
Electrical Panels distribution: JOH-ICD-S5-01-056-XXX-03-SD-EL-011630_1
wiring diagram opera lift
Acoustic Letter: L-OTIS-MBL-OPE-26-0015

DRAWING / DOCUMENT REFERENCE

NO.	NUMBER	TITLE	REV
01	L-12	JOH-HLA-S4-01-056-XXX-02-DR-AR-011120	F00
02		JOH-BHC-S4-01-056-XXX-XX-DR-VT-015001	
03		JOH-BHC-S4-01-056-XXX-XX-DR-VT-010001	
04		JOH-BHC-S4-01-056-005-ZZ-DR-VT-013001	
05		JOH-BHC-S4-01-056-005-ZZ-DR-VT-011001	
06		TQ-OPE-MBL-JCDC-00222	
07		JCD-OPE-MBL-MR-003-NMR-601-03	
08		JCD-OPE-MBL-MR-003-NMR-602-01	
09		TR-OPE-MBL-JCDC-05193-01	
10		TQ-OPE-MBL-JCDC-01287	

ELEV-L12 ELEVATOR GENERAL SPECIFICATIONS

LIFT NUMBER	ELEV.L12
CABIN INTERNAL SIZE(WXDXH)	1400x2450x2600
CAPACITY	1800 Kg
CLEAR ENTRANCE	1100X2400
CONTROL	VVVF
CONTROL SYSTEM	SIMPLEX FULL COLLECTIVE
COUNTERWEIGHT SAFETY	NO
DOOR TYPE	TLD2
EMERGENCY EXITS	-
FRONT OPENING	5
HEAT RELEASE	1774Kcal/h
HOISTWAY SIZE(HWXHD)	2400X3100
LIFT NUMBER	ELV.L12
LIGHTING SUPPLY	220V 60HZ
MIN.FLOOR HEIGHT	3000
NO. OF FLOOR	10
NO. OF OPENINGS	11
NO. OF UNITS	1
NON-STOP FLOORS	-
NON-STOP FLOORS NAMES	-
NUMBER OF PASSENGERS	24P
OVERHEAD	5400mm
PIT DEPTH	1600mm
POWER SUPPLY	380V 3P 60HZ
PRODUCT NO.	GeN2 MRL
RATED CURRENT(A)	31.4
REAR OPENING	6
ROPING	2:1
SPEED(m/s)	1.00
START CURRENT(A)	34.4
SYSTEM POWER(KW)	16.6
TRAVEL	34850mm
USE	~~PASSENGER LIFT~~ technical

SCEC – K&A Reviewed
Civil
Arch.
Elec.
ELV.
Mech.
Acoustic

CONTROLLED COPY
MBL IFC
JEDDAH OPERA HOUSE PROJECT
QA/QC Department
MBL QAM
Engr. Mudassar Altaf


SCEC – K&A Reviewed
Code B – Approved with Comments
(Do not Resubmit)

9-this note is rejected , it is contractor sole responsibility to submit a complete coordinated shop-drawing connection details with wall finishes ,architraves floor threshold connection and liner/top door connection

Disclaimer :K&A Khatib Alami – Saudi Consolidated Engineering review and/or approval does not relieve the Contractor from obligation to adhere to Contract Documents. The Contractor remains fully responsible for the accuracy, completeness, coordination, and compliance of all submitted documents and works

1-shaft size to be extracted from federated model
2-contractor must take in consideration as built dimensions and conditions prior execution
3- FFL Levels shall match the federated model levels and as per site conditions
4- Elevator Car Sizes/**dimensions** and Floors Being Served by the Elevators shall be as per approved TBE and further to OTIS letter **TQ-05809** and lift deviation letter ref:**TQ-OPE-MBL-JCDC-01330**
5- car interior finishes shall be submitted in a separate submission for approval
6-HOISTWAY PRESSURIZATION is not provided contractor shall confirm its requirement prior execution
7-Contractor to update the missing reference when submitting the coordination drawing with wall finishing
8-hoistway entrance to be verified by contractor by the contractor to align with OTIS proposed drawings
9-stair ladder shall be submitted separately for apporval
Structural comments:
8-Structural design of brackets including their anchor bolts into the concrete walls for the lift loads is to be submitted for checking and approval.
Otherwise, evident for its adequacy is to be provided.

dar Dar Al-Handasah consultants (Shair and Partners)
Checked and Reviewed

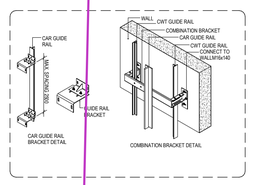


NOTE No.:
FRONT WALLS,FINISHES & ARCHITRAVES TO BE BUILT (BY CLIENT) AFTER THE INSTALLATION OF THE (LANDING) EXTERNAL DOORS.

IMPORTANT NOTE FOR MAIN CONTRACTOR.
FREEDOM OF ACCESS MUST BE AVAILABLE FOR POINT OF ENTRY INTO THE BUILDING UP TO THE ELEVATOR HOIST WAY AND THE FRONT WALLS OF THE HOIST WAY AT MAIN FLOOR TO BE LEFT OPEN FOR FULL WIDTH AND HEIGHT TO PERMIT ENTRY OF OUR EQUIPMENT.

REACTIONS FORCE (KN)

Car side rail		CWT guide rail		Pit reaction	
R=	86	R=	25	U=	174
R1=	3.84	R1=	1.65	V=	137
R2=	2.67	R2=	0.26		

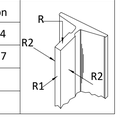

LEGEND

HW	HOIST WAY WIDTH
HD	HOIST WAY DEPTH
CRH	CAR ROUGH HEIGHT
DOOR OP	DOOR OPENING
ROP	ROUGH OPENING
CW	CAR WIDTH
CD	CAR DEPTH
CH	CAR HEIGHT
DBG	DISTANCE BETWEEN GUARDRAIL
CWT	COUNTERWEIGHT
E&I PANEL	EMERGENCY & INSPECTION PANEL
G.O.V	CAR GOVERNOR
COP	CAR OPERATING PANEL
HBP	HALL BUTTON POSITION INDICATOR

REVIEWED BY DISCIPLINE	SIGNATURE	DATE
ARCHITECTURAL	[illegible]	[illegible]
STRUCTURAL	[illegible]	[illegible]
MECHANICAL	[illegible]	[illegible]
PLUMBING	[illegible]	[illegible]
ELECTRICAL	[illegible]	[illegible]
ICT	[illegible]	[illegible]
ADDITIONAL DISCIPLINES TO BE ADDED AS REQUIRED		

REV	DATE	BY	DESCRIPTION	CHK	APD
S00	15-MAY-2026	AK	Issued for Approval	SS	AB

DRAWING STATUS: CONSTRUCTION SHOPDRAWING

CLIENT: Jeddah Central Development Co.

LEAD DESIGN CONSULTANTS: Henning Larsen

LEAD ENGINEERING CONSULTANT: BURO HAPPOLD

PROJECT SUPERVISION CONSULTANT: K&A Khatib & Alami

GENERAL CONTRACTOR: MBL

REVIEWER: dar

SUB CONTRACTOR: OTIS ELEVATOR COMPANY (SAUDI ARABIA) LIMITED

PROJECT: JEDDAH OPERA HOUSE

TITLE: OPERA BUILDING
VERTICAL TRANSPORTATION
PART 004
PLANS - LIFT SHAFT SHEET 02 OF 02 (L12)


SCALE @ A1:	CHECKED:	APPROVED:
As indicated	SS	AB

PROJECT No:	DESIGNED:	DRAWN:	DATE:
440014	AK	PR	15-MAY-2026

DRAWING No: JOH-OTS-S5-01-056-004-ZZ-SD-VT-011001 REV: S00

MODEL FILE REF: JOH-OTS-S5-01-056-XXX-ZZ-M3-VT-010001


© JCDC

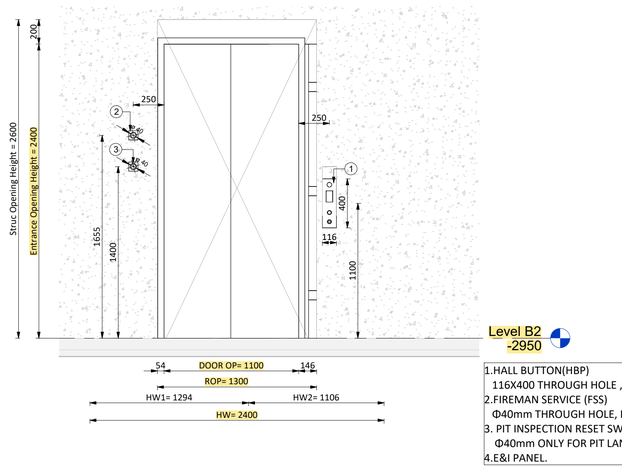

1.HALL BUTTON(HBP)
116X400 THROUGH HOLE ,IN THE DISCRETIONARY FLOOR
2.FIREMAN SERVICE (FSS)
Φ40mm THROUGH HOLE, IN THE MAIN FLOOR
3. PIT INSPECTION RESET SW
Φ40mm ONLY FOR PIT LANDING
4.E&I PANEL.


1 Door Elevation At "B2" Floor (Front) - ELEV-L12

1 : 25

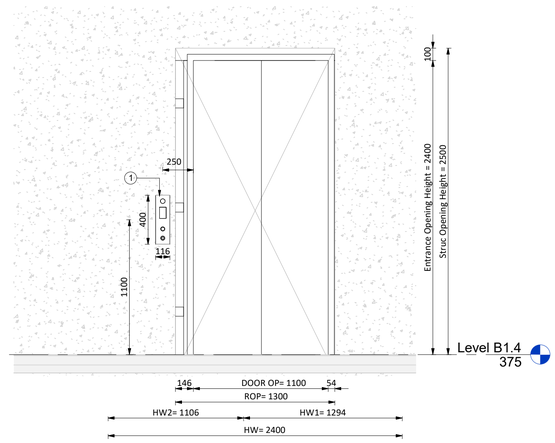

2 Door Elevation At "B1,2,3,4" Floor (Rear) - ELEV-L12

1 : 25

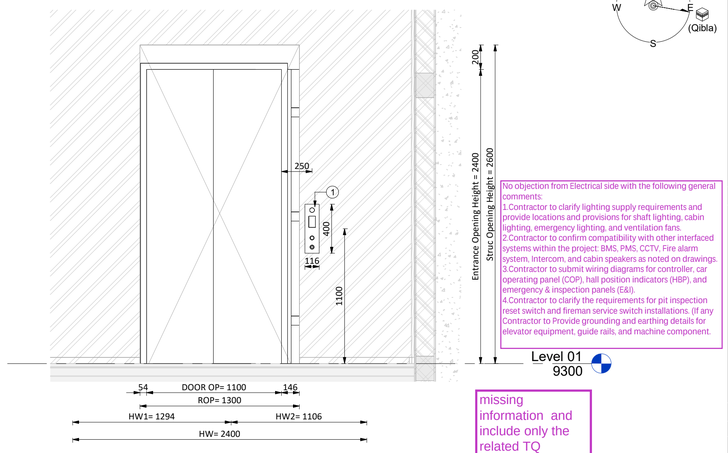


No objection from Electrical side with the following general comments:
1.Contractor to clarify lighting supply requirements and provide locations and provisions for shaft lighting, cabin lighting, emergency lighting, and ventilation fans.
2.Contractor to confirm compatibility with other interfaced systems within the project: BMS, PMS, CCTV, Fire alarm system, Intercom, and cabin speakers as noted on drawings.
3.Contractor to submit wiring diagrams for controller, car operating panel (COP), hall position indicators (HBP), and emergency & inspection panels (E&I).
4.Contractor to clarify the requirements for pit inspection reset switch and fireman service switch installations. (If any Contractor to Provide grounding and earthing details for elevator equipment, guide rails, and machine component.

missing information and include only the related TQ

3 Door Elevation At "G,1,2" Floor (Front) - ELEV-L12

1 : 25

add the letter references TQ-05809 & deviation letter

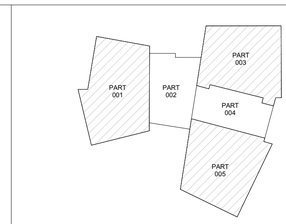

KEY PLAN

GENERAL NOTES: ALL LEVELS SHOWN ON THE DRAWING ARE CHART DATUM LEVELS PROJECT LEVEL+0.000 = +3.700 CHART DATUM.

Refer to :
LIFTS overhead steel hook beams structural calculation and fixation details: TR-OPE-MBL-JCDC-05193-S01
Electrical Panels distribution: JOH-ICD-S5-01-056-XXX-03-SD-EL-011630_1
wiring diagram opera lift
Acoustic Letter: L-OTIS-MBL-OPE-26-0015

DRAWING / DOCUMENT REFERENCE

NO.	NUMBER	TITLE	REV.
01	L-12	JOH-HLA-S4-01-056-XXX-02-DR-AR-011120	F00
02		JOH-BHC-S4-01-056-XXX-XX-DR-VT-015001	
03		JOH-BHC-S4-01-056-XXX-XX-DR-VT-010001	
04		JOH-BHC-S4-01-056-005-ZZ-DR-VT-013001	
05		JOH-BHC-S4-01-056-005-ZZ-DR-VT-011001	
06		TQ-OPE-MBL-JCDC-00222	
07		JCD-OPE-MBL-MR-003-NMR-601-03	
08		JCD-OPE-MBL-MR-003-NMR-602-01	
09		TR-OPE-MBL-JCDC-05193-01	
10		TQ-OPE-MBL-JCDC-01287	

4 Door Elevation At 5 Floor (Rear) - ELEV-L12


1 : 25

5 Door Elevation At "6" Floor (Front) - ELEV-L12

1 : 25


6 Cross-Section View A-A - ELEV-L12

1 : 25

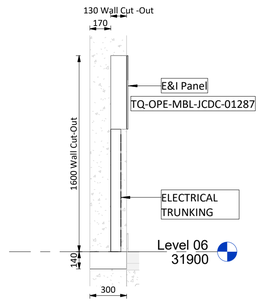

7 Cross-Section View B-B - ELEV-L12

1 : 25

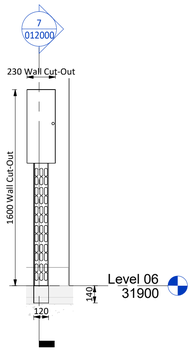


8 E&I SPOT DETAIL - ELEV-L12

1 : 25


MBL to provide a comprehensive Method Statement describing the procedure for filling all gaps and correcting / adjusting the rough openings for doors.

Checked and Reviewed

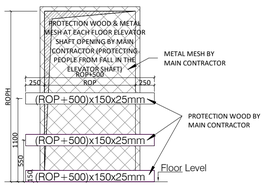

Protection Elevation Detail
At Each Elevator Shaft Opening

Simplex Units

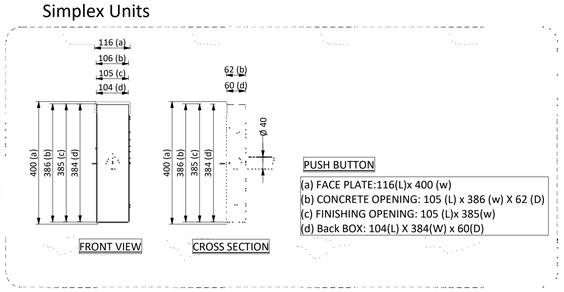

LEGEND	
HW	HOIST WAY WIDTH
HD	HOIST WAY DEPTH
CRH	CAR ROUGH HEIGHT
DOOR OP	DOOR OPENING
ROP	ROUGH OPENING
CW	CAR WIDTH
CD	CAR DEPTH
CH	CAR HEIGHT
DBG	DISTANCE BETWEEN GUARDRAIL
CWT	COUNTERWEIGHT
E&I PANEL	EMERGENCY & INSPECTION PANEL
G.O.V	CAR GOVERNOR
COP	CAR OPERATING PANEL
HBP	HALL BUTTON POSITION INDICATOR

CONTROLLED COPY
MBL IFC
JEDDAH OPERA HOUSE PROJECT
QA/QC Department
MBL QAM
Engr. Mudassar Altaf

SCEC – K&A Reviewed
Code B – Approved with Comments
(Do not Resubmit)

SCEC – K&A Reviewed
Civil
Arch.
Elec.
ELV.
Mech.
Acoustic

Disclaimer :K&A Khatib Alami – Saudi Consolidated Engineering review and/or approval does not relieve the Contractor from obligation to adhere to Contract Documents. The Contractor remains fully responsible for the accuracy, completeness, coordination, and compliance of all submitted documents and works

1-shaft size to be extracted from federated model
2-contractor must take in consideration as built dimensions and conditions prior execution
3- FFL Levels shall match the federated model levels and as per site conditions
4- Elevator Car Sizes/**dimensions** and Floors Being Served by the Elevators shall be as per approved TBE and further to OTIS letter **TQ-05809** and lift deviation letter ref:**TQ-OPE-MBL-JCDC-01330**
5- car interior finishes shall be submitted in a separate submission for approval
6-HOISTWAY PRESSURIZATION is not provided contractor shall confirm its requirement prior execution
7-Contractor to update the missing reference when submitting the coordination drawing with wall finishing
8-hoistway entrance to be verified by contractor by the contractor to align with OTIS proposed drawings
9-stair ladder shall be submitted separately for approval
Structural comments:
8-Structural design of brackets including their anchor bolts into the concrete walls for the lift loads is to be submitted for checking and approval.
Otherwise, evident for its adequacy is to be provided.

REVIEWED BY DISCIPLINE	SIGNATURE	DATE
ARCHITECTURAL	[illegible]	[illegible]
STRUCTURAL	[illegible]	[illegible]
MECHANICAL	[illegible]	[illegible]
PLUMBING	[illegible]	[illegible]
ELECTRICAL	[illegible]	[illegible]
ICT	[illegible]	[illegible]
ADDITIONAL DISCIPLINES TO BE ADDED AS REQUIRED		

REV	DATE	BY	DESCRIPTION	CHK	APD
S00	15-MAY-2026	AK	Issued for Approval	SS	AB

DRAWING STATUS: CONSTRUCTION SHOPDRAWING

CLIENT: Jeddah Central Development Co.

LEAD DESIGN CONSULTANTS: Henning Larsen

LEAD ENGINEERING CONSULTANT: BURO HAPPOLD

PROJECT SUPERVISION CONSULTANT: K&A Khatib & Alami

GENERAL CONTRACTOR: MBL

REVIEWER: dar

SUB CONTRACTOR: OTIS ELEVATOR COMPANY (SAUDI ARABIA) LIMITED — OTIS

PROJECT: JEDDAH OPERA HOUSE

TITLE: OPERA BUILDING
VERTICAL TRANSPORTATION
PART 004
ELEVATIONS - LIFT SHAFT (L12)


SCALE @ A1:	CHECKED:	APPROVED:
As indicated	SS	AB

PROJECT No:	DESIGNED:	DRAWN:	DATE:
440014	AK	PR	15-MAY-2026

DRAWING No: JOH-OTS-S5-01-056-004-ZZ-SD-VT-012000 REV: S00


MODEL FILE REF: JOH-OTS-S5-01-056-XXX-ZZ-M3-VT-010001

© JCDC

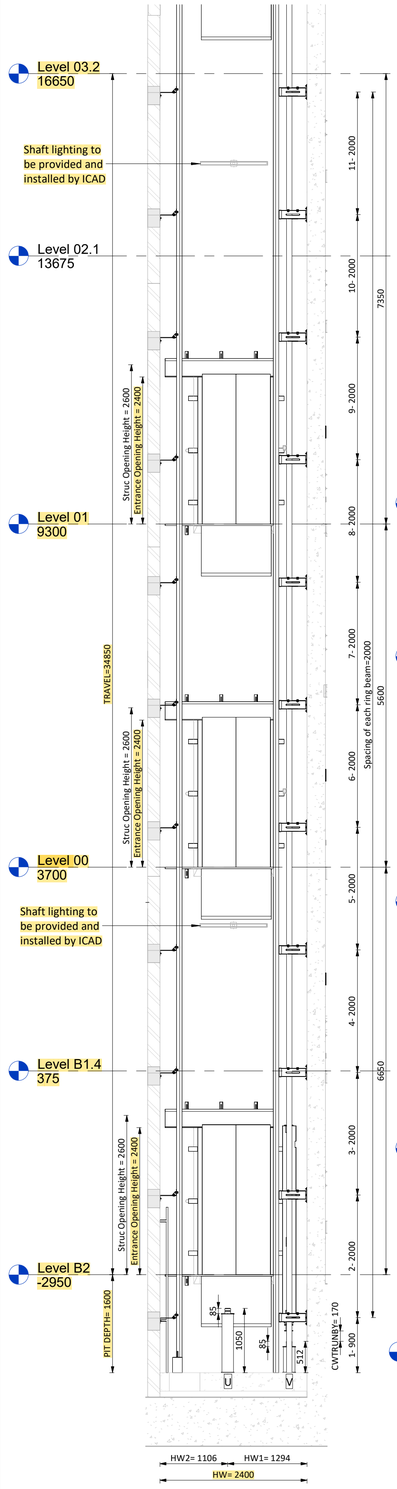


1 Section "A" - ELEV-L12


1 : 50

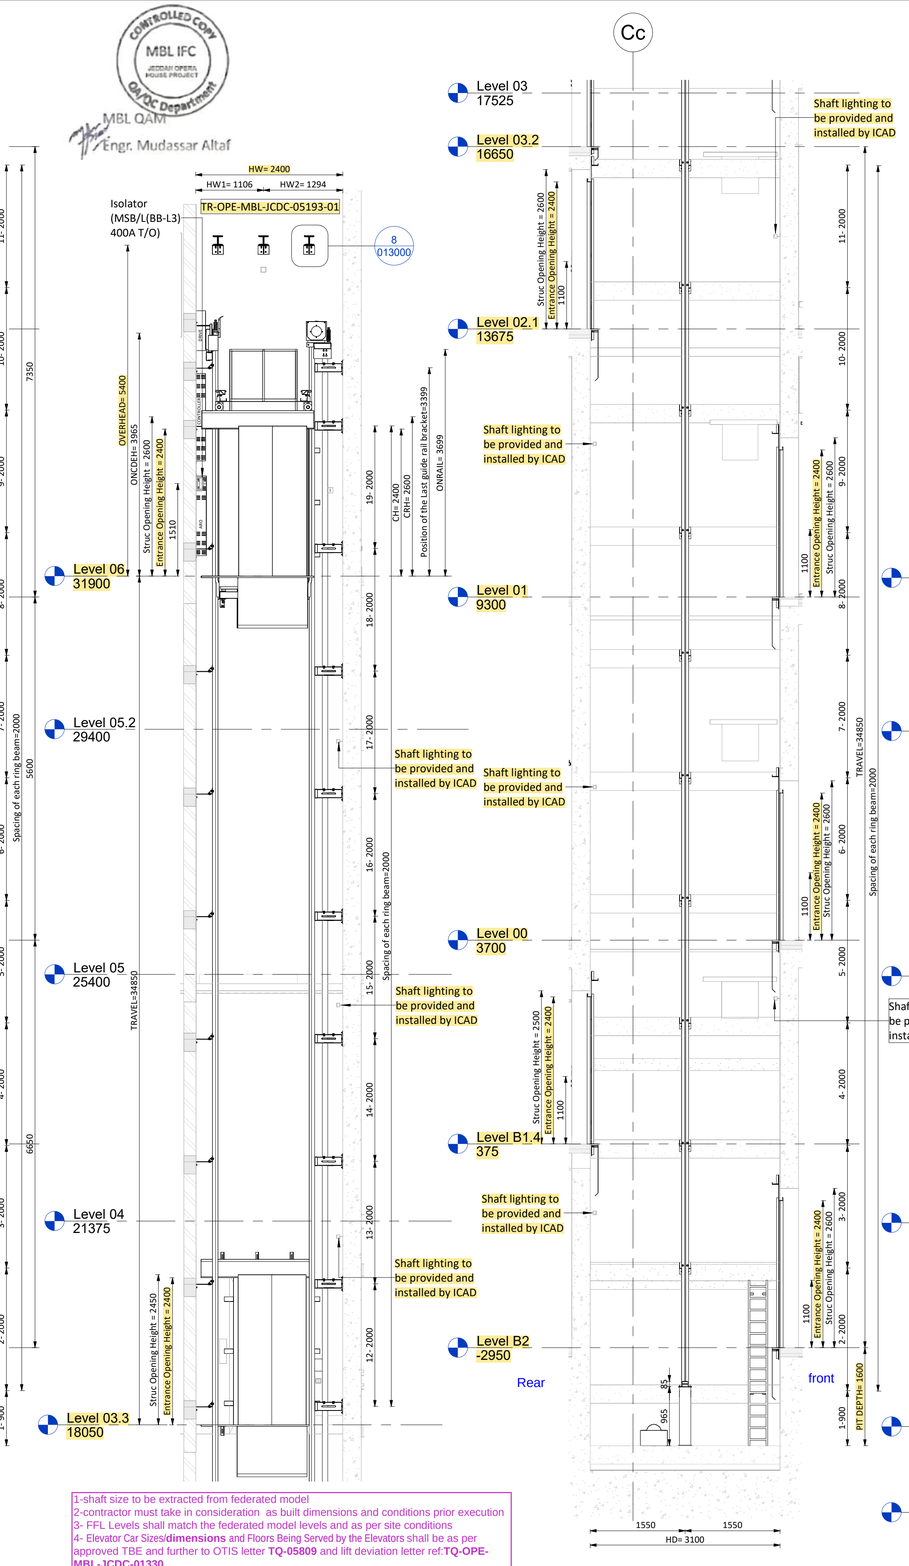

2 Section"B" - ELEV-L12


1 : 50

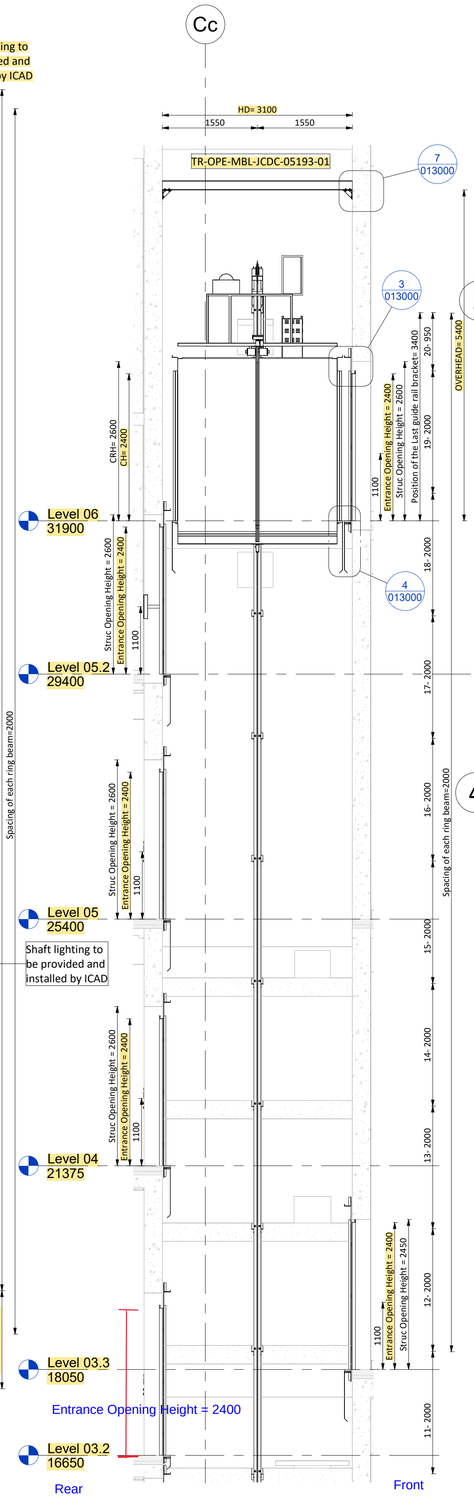

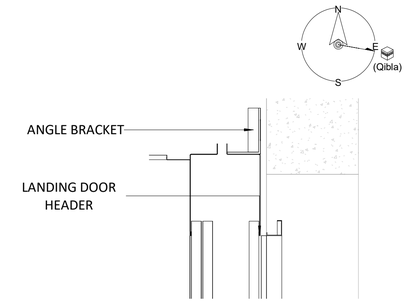


3 Landing Door Header Detail - ELEV-L12

1 : 10

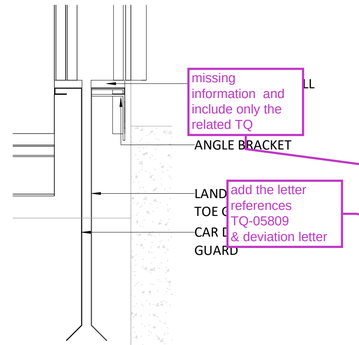


4 Landing Door Bottom Detail - ELEV-L12

1 : 10

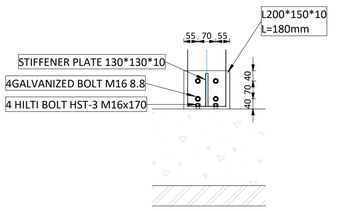


5 DETAIL (A)

1 : 12

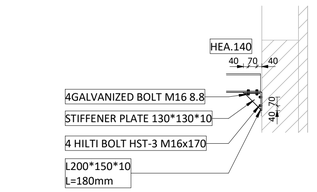


6 DETAIL (A1-A1)

1 : 25

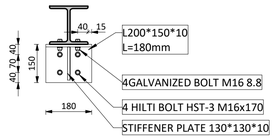

7 DETAIL (B1-B1)

1 : 12

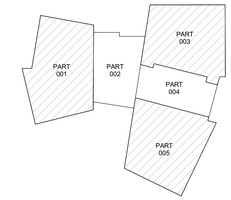

KEY PLAN

GENERAL NOTES: ALL LEVELS SHOWN ON THE DRAWING ARE CHART DATUM LEVELS PROJECT LEVEL+0.000 = +3.700 CHART DATUM.

Refer to :
LIFTS overhead steel hook beams structural calculation and fixation details: TR-OPE-MBL-JCDC-05193-S01
Electrical Panels distribution: JOH-ICD-S5-01-056-XXX-03-SD-EL-011630_1
wiring diagram opera lift
Acoustic Letter: L-OTIS-MBL-OPE-26-0015

DRAWING / DOCUMENT REFERENCE

NO.	NUMBER	TITLE	REV
01	L-12	JOH-HLA-S4-01-056-XXX-02-DR-AR-011120	F00
02		JOH-BHC-S4-01-056-XXX-XX-DR-VT-015001	
03		JOH-BHC-S4-01-056-XXX-XX-DR-VT-010001	
04		JOH-BHC-S4-01-056-005-ZZ-DR-VT-013001	
05		JOH-BHC-S4-01-056-005-ZZ-DR-VT-011001	
06		TQ-OPE-MBL-JCDC-00222	
07		JCD-OPE-MBL-MR-003-NMR-601-03	
08		JCD-OPE-MBL-MR-003-NMR-602-01	
09		TR-OPE-MBL-JCDC-05193-01	
10		TR-OPE-MBL-JCDC-01287	

REVIEWED BY DISCIPLINE	SIGNATURE	DATE
ARCHITECTURAL	[illegible]	[illegible]
STRUCTURAL	RC	[illegible]
MECHANICAL	SA.A	[illegible]
PLUMBING	SA.A	[illegible]
ELECTRICAL	SA.A	2026-06-03
ICT	SA.A	2026-[illegible]
ADDITIONAL DISCIPLINES TO BE ADDED AS REQUIRED		

REV	DATE	BY	DESCRIPTION	CHK	APD
S00	15-MAY-2026	AK	Issued for Approval	SS	AB

DRAWING STATUS: CONSTRUCTION SHOPDRAWING

CLIENT: شركة وسط جدة للتطوير Jeddah Central Development Co.

LEAD DESIGN CONSULTANTS: Henning Larsen

LEAD ENGINEERING CONSULTANT: BURO HAPPOLD

PROJECT SUPERVISION CONSULTANT: KHATIB & ALAMI

GENERAL CONTRACTOR: MBL

REVIEWER: dar

SUB CONTRACTOR: OTIS ELEVATOR COMPANY SAUDI ARABIA LIMITED — OTIS

PROJECT: JEDDAH OPERA HOUSE

TITLE: OPERA BUILDING
VERTICAL TRANSPORTATION
PART 004
SECTIONS - LIFT SHAFT (L12)

SCALE @ A1:	CHECKED:	APPROVED:
As indicated	SS	AB

PROJECT No:	DESIGNED:	DRAWN:	DATE:
440014	AK	PR	15-MAY-2026

DRAWING No: JOH-OTS-S5-01-056-004-ZZ-SD-VT-013000 REV: S00

MODEL FILE REF: JOH-OTS-S5-01-056-XXX-ZZ-M3-VT-010001

© JCDC

CONTROLLED COPY
MBL IFC
JEDDAH OPERA HOUSE PROJECT
QA/QC Department
MBL QAM
Engr. Mudassar Altaf

Disclaimer :K&A Khatib Alami – Saudi Consolidated Engineering review and/or approval does not relieve the Contractor from obligation to adhere to Contract Documents. The Contractor remains fully responsible for the accuracy, completeness, coordination, and compliance of all submitted documents and works

1-shaft size to be extracted from federated model
2-contractor must take in consideration as built dimensions and conditions prior execution
3- FFL Levels shall match the federated model levels and as per site conditions
4- Elevator Car Sizes/**dimensions** and Floors Being Served by the Elevators shall be as per approved TBE and further to OTIS letter **TQ-05809** and lift deviation letter ref:**TQ-OPE-MBL-JCDC-01330**
5- car interior finishes shall be submitted in a separate submission for approval
6-HOISTWAY PRESSURIZATION is not provided contractor shall confirm its requirement prior execution
7-Contractor to update the missing reference when submitting the coordination drawing with wall finishing
8-hoistway entrance to be verified by contractor by the contractor to align with OTIS proposed drawings
9-stair ladder shall be submitted separately for approval
Structural comments:
8-Structural design of brackets including their anchor bolts into the concrete walls for the lift loads is to be submitted for checking and approval.
Otherwise, evident for its adequacy is to be provided.

No objection from Electrical side with the following general comments:
1.Contractor to clarify lighting supply requirements and provide locations and provisions for shaft lighting, cabin lighting, emergency lighting, and ventilation fans.
2.Contractor to confirm compatibility with other interfaced systems within the project: BMS, PMS, CCTV, Fire alarm system, Intercom, and cabin speakers as noted on drawings.
3.Contractor to submit wiring diagrams for controller, car operating panel (COP), hall position indicators (HIP), and emergency & inspection panels (E&I).
4.Contractor to clarify the requirements for pit inspection reset switch and fireman service switch installations. (If any Contractor to Provide grounding and earthing details for elevator equipment, guide rails, and machine component.

SCEC – K&A Reviewed
Civil
Arch.
Elec.
ELV.
Mech.
Acoustic

SCEC – K&A Reviewed
Code B – Approved with Comments
(Do not Resubmit)

dar Al Handasah consultants (Shair and Partners)
Checked and Reviewed