

Lift 17

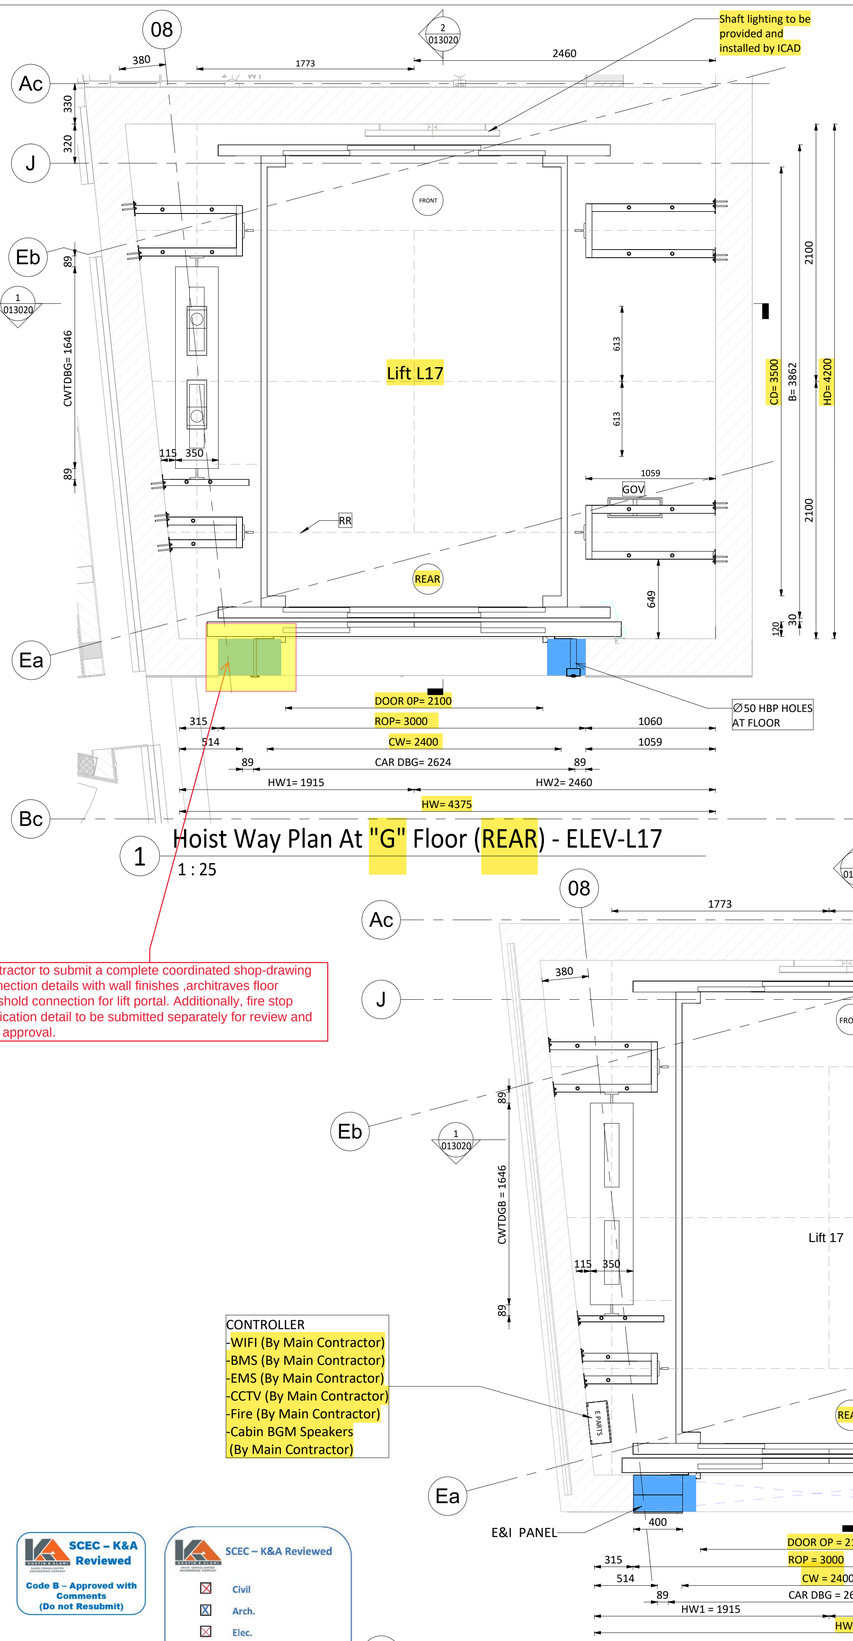


1 Hoist Way Plan At "G" Floor (REAR) - ELEV-L17

1 : 25

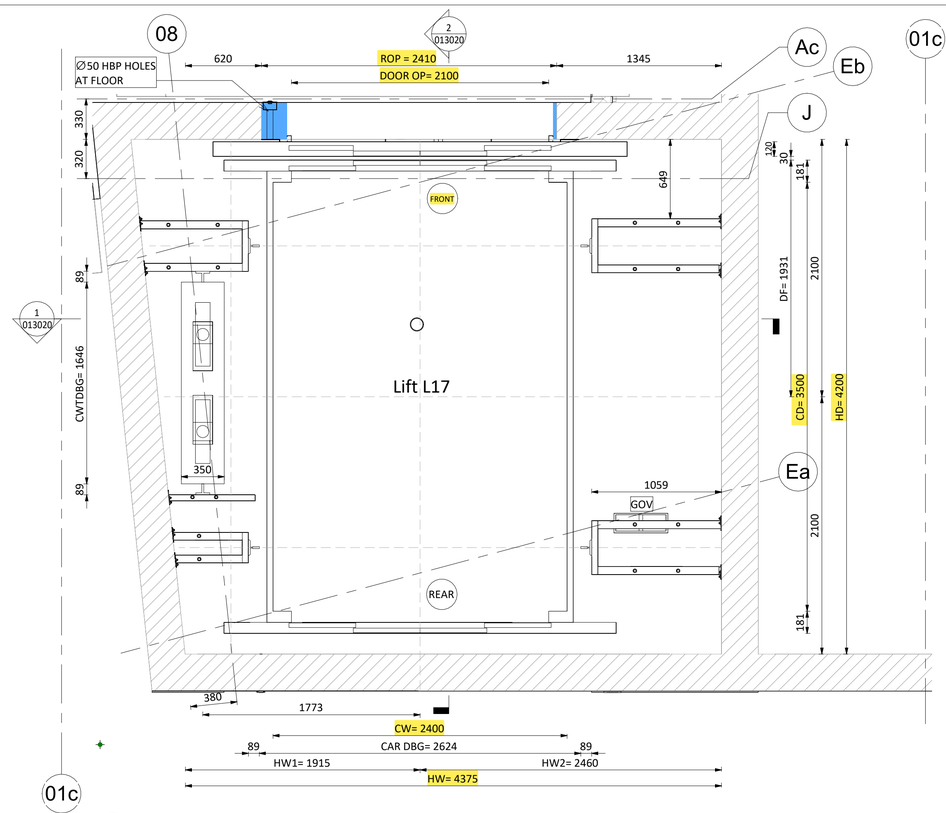

2 Hoist Way Plan At "1" Floor (FRONT) - ELEV-L17

1 : 25

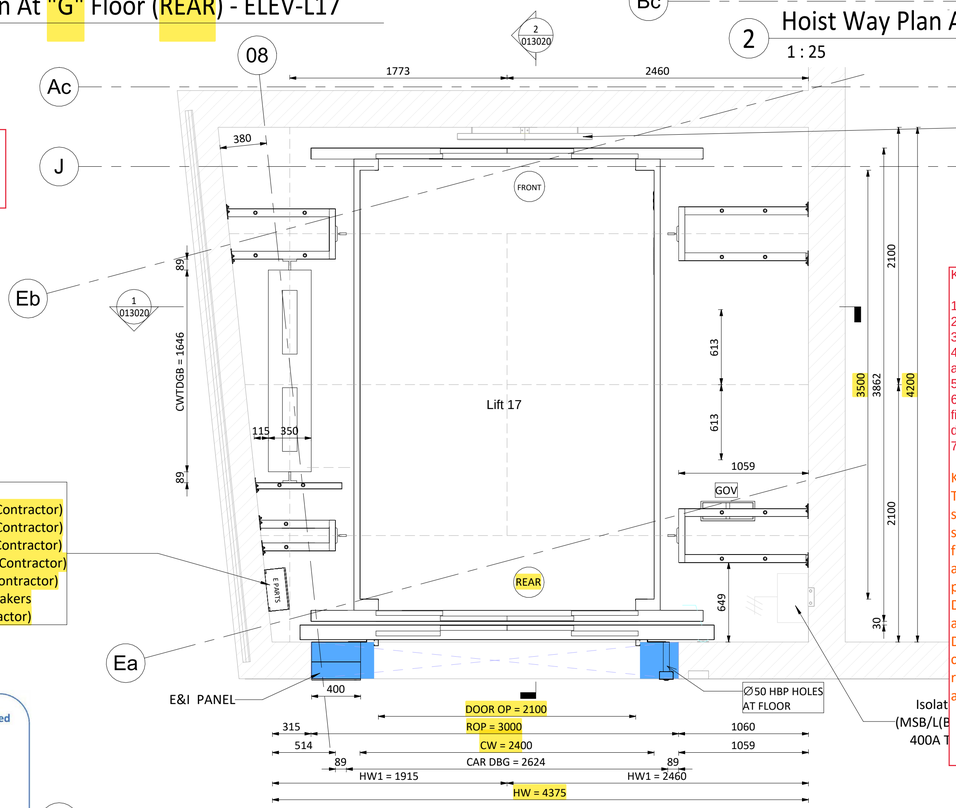

3 Hoist Way Plan At "2" Floor (REAR) - ELEV-L17

1 : 25

Contractor to submit a complete coordinated shop-drawing connection details with wall finishes ,architraves floor threshold connection for lift portal. Additionally, fire stop application detail to be submitted separately for review and FLS approval.

Shaft lighting to be provided and installed by ICAD

CONTROLLER
-WIFI (By Main Contractor)
-BMS (By Main Contractor)
-EMS (By Main Contractor)
-CCTV (By Main Contractor)
-Fire (By Main Contractor)
-Cabin BGM Speakers (By Main Contractor)

CONTROLLED COPY
MBL IFC
JEDDAH OPERA HOUSE PROJECT
QA/QC Department
MBL QAM
Engr. Mudassar Altaf

K&A ARCH COMMENTS :

1- Shaft size to be extracted from federated model.
2- Contractor must take in consideration as built dimensions and conditions prior execution.
3- FFL Levels shall match the federated model levels and as per site conditions.
4- Elevator Car Sizes/dimensions and Floors Being Served by the Elevators shall be as per approved TBE and further to OTIS letter TR-05809 and lift deviation letter.
5- Car interior finishes shall be submitted in a separate submission for approval.
6- Contractor to submit a complete coordinated shop-drawing connection details with wall finishes ,architraves floor threshold connection for lift portal. Additionally, fire stop application detail to be submitted separately for review and FLS approval.
7- Access ladder shall be submitted separately for approval.


K&A Acoustic Comments:
The 10 mm thick isolator bearings shall provide continuous separation between the steel bracket and the supporting structure, with no rigid metal-to-metal contact. The stabilizer bearings, elastomeric sleeves and washers shall be installed such that the fixing bolts do not create a noise/vibration bridge through the isolator. The fixing arrangement shall include suitable elastomeric sleeves/bushes and isolated washers to prevent direct transmission through bolts and fixings.
Disclaimer: K&A Khatib & Alami – Saudi Consolidated Engineering's review and/or approval does not relieve the Contractor of its obligations under the Contract Documents. The Contractor remains fully responsible for the accuracy, completeness, coordination, and compliance of all submitted documents and executed works. Such review and/or approval shall not constitute acceptance of, or entitlement to, any additional time or cost impact.


SCEC – K&A Reviewed
Code B – Approved with Comments (Do not Resubmit)

SCEC – K&A Reviewed
- [x] Civil
- [x] Arch.
- [x] Elec.
- [x] ELV.
- [x] Mech.
- [x] Acoustic


Refer to:
For Hooks design TQ-OPE-MBL-JCDC-00952
For Electrical Panels distribution: JOH-ICD-S5-01-056-XXX-02-SD-EL-011620
Attached wiring diagram opera lift
Attached Acoustic Letter: L-OTIS-MBL-OPE-26-0015

dar Dar Al Handasah consultants (Shair and Partners)
Checked and Reviewed

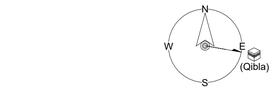

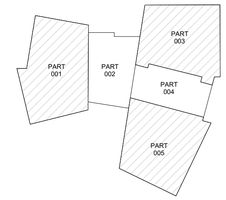

KEY PLAN

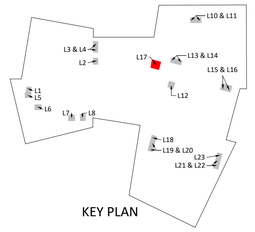

KEY PLAN

GENERAL NOTES: ALL LEVELS SHOWN ON THE DRAWING ARE CHART DATUM LEVELS PROJECT LEVEL+0.000 = +3.700 CHART DATUM.

Notes:
* All shop drawings have been extracted from the BIM federated model.
* The Contractor will carry out a site survey prior to execution.
* All levels indicated have been taken from the federated model.
* All car dimensions are in accordance with the approved TBE.
* Car interior finishes will be submitted under a separate submittal.
* No hoist-way pressurization is required for the Opera Building.
- MBL will provide a comprehensive Method Statement describing the procedure for filling all gaps and correcting / adjusting the rough openings for doors
* Ladder specification:
  * Type: Folding ladder (With a switch to protect the maintenance in the pit)
  * Material: Q235 tube (welding and painted yellow)
  * Length: About 1100mm above bottom landing
  * Note: the ladder will be divided into two parts to deliver

ELEV-L17 ELEVATOR GENERAL SPECIFICATIONS

LIFT NUMBER	Comments
CABIN INTERNAL SIZE(WXDXH)	2400X3500X2500
CAPACITY	5000Kg
CLEAR ENTRACE	2100X2400
CONTROL	VVVF
CONTROL SYSTEM	SIMPLEX FULL COLLECTIVE
COUNTERWEIGHT SAFETY	NO
DOOR TYPE	CLD
EMERGENCY EXITS	-
REAR OPENING	2 FRONT OPINING : 1
HEAT RELEASE	-
HOISTWAY SIZE(HWXHD)	4375X4200
LIFT NUMBER	ELV.L17
LIGHTING SUPPLY	230V 60HZ
MIN.FLOOR HEIGHT	3070
NO. OF FLOOR	3
NO. OF OPENINGS	3
NO. OF UNITS	1
NON-STOP FLOORS	-
NON-STOP FLOORS NAMES	-
NUMBER OF PASSENGERS	66P
OVERHEAD	5400
PIT DEPTH	1800
POWER SUPPLY	400V 3P 60HZ
PRODUCT NO.	FOVF
RATED CURRENT(A)	75
FRONT OPENING	1
ROPING	4:1
SPEED(m/s)	1.00
START CURRENT(A)	150
SYSTEM POWER(KW)	33.1
TRAVEL	9975
USE	SERVICE LIFT

REACTIONS FORCE (KN)	
R1=	196
R2=	146
R3=	261
R4=	75
R5=	45.6
PR=	152

LEGEND	
HW	HOIST WAY WIDTH
HD	HOIST WAY DEPTH
CRH	CAR ROUGH HEIGHT
DOOR OP	DOOR OPENING
ROP	ROUGH OPENING
CW	CAR WIDTH
CD	CAR DEPTH
CH	CAR HEIGHT
DBG	DISTANCE BETWEEN GUARDRAIL
CWT	COUNTERWEIGHT
E&I PANEL	EMERGENCY & INSPECTION PANEL
G.O.V	CAR GOVERNOR
COP	CAR OPERATING PANEL
HBP	HALL POSITION INDICATOR

NOTE No.:
FRONT WALLS,FINISHES & ARCHITRAVES TO BE BUILT (BY MBL) AFTER THE INSTALLATION OF THE (LANDING) EXTERNAL DOORS.

IMPORTANT NOTE FOR MAIN CONTRACTOR.
FREEDOM OF ACCESS MUST BE AVAILABLE FOR POINT OF ENTRY INTO THE BUILDING UP TO THE ELEVATOR HOIST WAY AND THE FRONT WALLS OF THE HOIST WAY AT MAIN FLOOR TO BE LEFT OPEN FOR FULL WIDTH AND HEIGHT TO PERMIT ENTRY OF OUR EQUIPMENT.

DRAWING / DOCUMENT REFERENCE

NO.	NUMBER	TITLE	REV.
01	L-17	JOH-HLA-S4-01-056-XXX-02-DR-AR-011120	F00
02		JOH-BHC-S4-01-056-XXX-XX-DR-VT-015001	
03		JOH-BHC-S4-01-056-XXX-XX-DR-VT-010001	
04		JOH-BHC-S4-01-056-005-ZZ-DR-VT-013001	
05		JOH-BHC-S4-01-056-005-ZZ-DR-VT-011001	
06		TQ-OPE-MBL-JCDC-00222	
07		JCD-OPE-MBL-MR-003-NMR-601-03	
08		JCD-OPE-MBL-MR-003-NMR-602-01	
09		TR-OPE-MBL-JCDC-06036	
10		TQ-OPE-MBL-JCDC-00952	

REVIEWED BY DISCIPLINE	SIGNATURE	DATE
ARCHITECTURAL	MT	2026-08-11
STRUCTURAL	PC	2026-08-11
MECHANICAL	Sh.A	2026-08-11
PLUMBING	Sh.A	2026-08-11
ELECTRICAL	Sh.A	2026-08-11
ICT	Sh.A	2026-08-11
ADDITIONAL DISCIPLINES TO BE ADDED AS REQUIRED		

REV	DATE	BY	DESCRIPTION	CHK	APD
S00	08-AUG-2026	Usha	Issued for Approval	Sakr Salma	Ali Basit

DRAWING STATUS:
CONSTRUCTION SHOPDRAWING

CLIENT:
شركة وسط جدة للتطوير
Jeddah Central Development Co.

LEAD DESIGN CONSULTANTS:
Henning Larsen

LEAD ENGINEERING CONSULTANT:
BURO HAPPOLD

PROJECT SUPERVISION CONSULTANT:
K&A KHATIB & ALAMI

GENERAL CONTRACTOR:
MBL

REVIEWER:
dar

SUB CONTRACTOR:
OTIS ELEVATOR COMPANY (SAUDI ARABIA) LIMITED
OTIS

PROJECT
JEDDAH OPERA HOUSE


TITLE:
OPERA BUILDING
VERTICAL TRANSPORTATION
PART 004
PLANS - LIFT SHAFT SHEET 01 OF 02 (L17)

SCALE @ A1:	CHECKED:	APPROVED:	
As indicated	Sakr Salma	Ali Basit	
PROJECT No: 440014	DESIGNED: Usha	DRAWN: Usha	DATE: 08-AUG-2026

DRAWING No: JOH-OTS-S5-01-056-004-ZZ-SD-VT-011020
REV: S00


MODEL FILE REF: JOH-OTS-S5-01-056-XXX-ZZ-M3-VT-010001

© JCDC

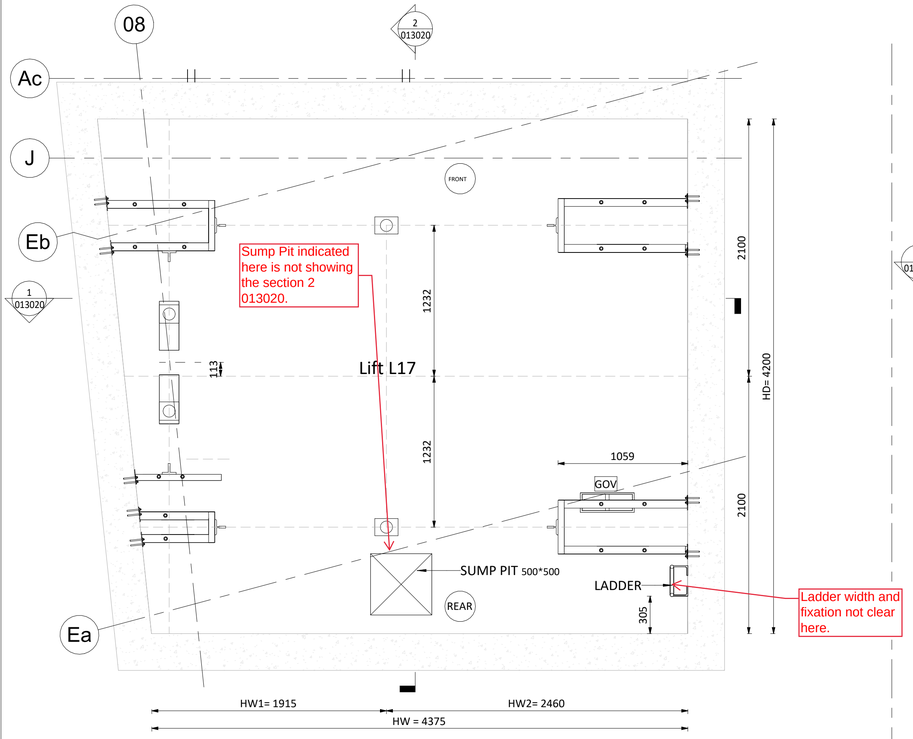


2 Pit Plan - ELEV-L17

1 : 25

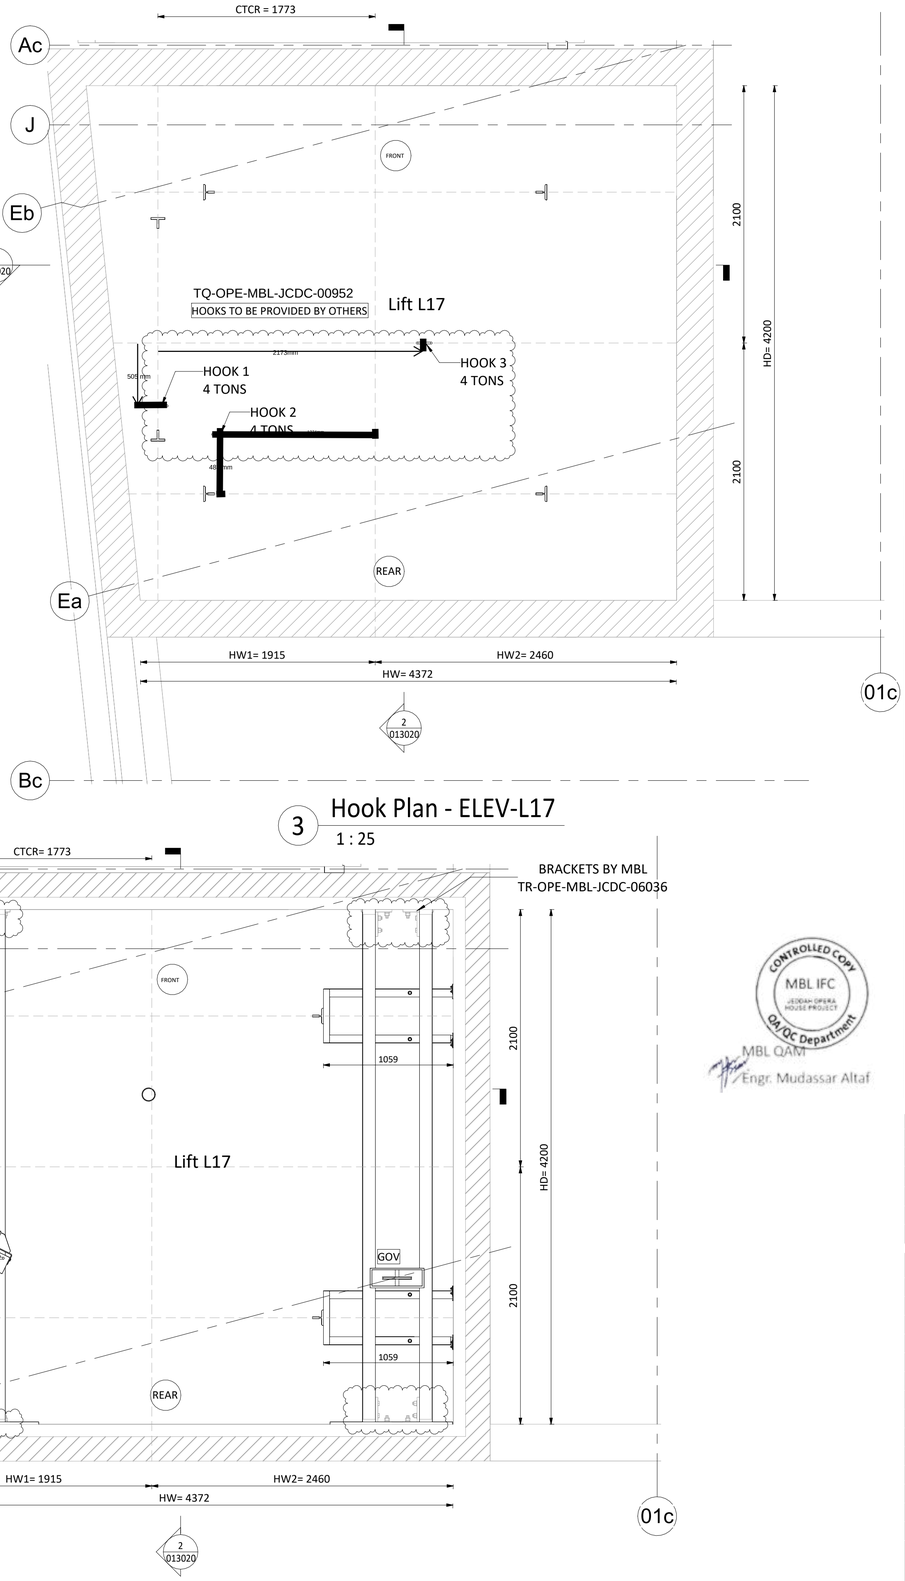

3 Hook Plan - ELEV-L17

1 : 25

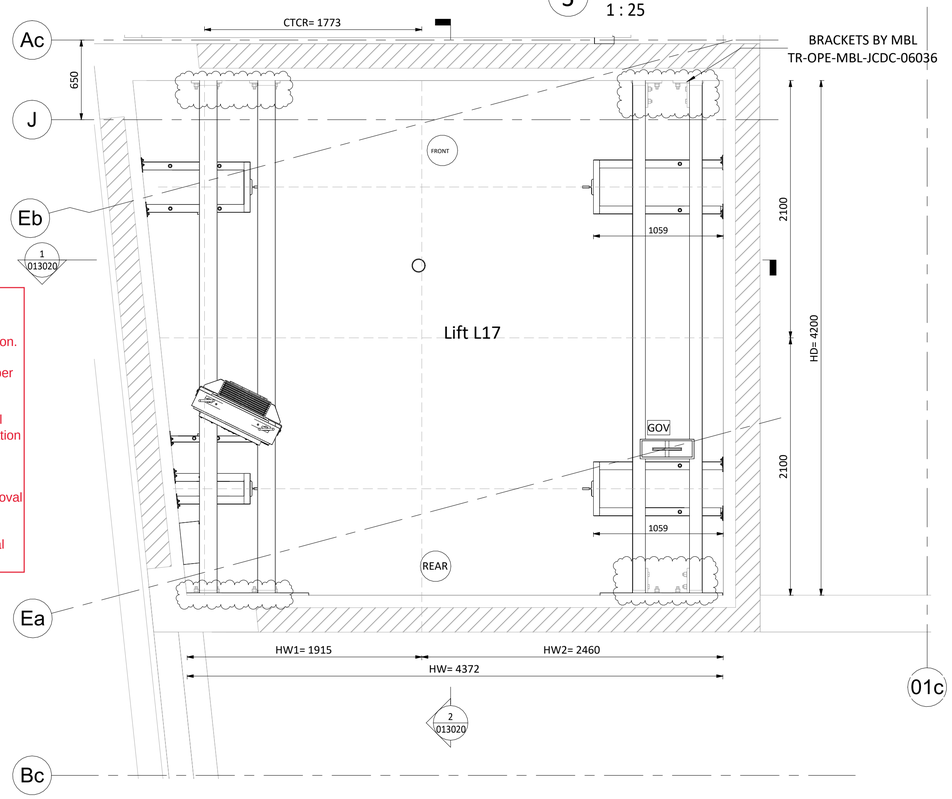

1 Machine Room Plan - ELEV-L17

1 : 25

SCEC – K&A Reviewed

- Civil
- Arch.
- Elec.
- ELV.
- Mech.
- Acoustic

SCEC – K&A Reviewed

Code B – Approved with Comments (Do not Resubmit)

K&A ARCH COMMENTS :


1- Shaft size to be extracted from federated model.
2- Contractor must take in consideration as built dimensions and conditions prior execution.
3- FFL Levels shall match the federated model levels and as per site conditions.
4- Elevator Car Sizes/dimensions and Floors Being Served by the Elevators shall be as per approved TBE and further to OTIS letter TR-05809 and lift deviation letter.
5- Car interior finishes shall be submitted in a separate submission for approval.
6- Contractor to submit a complete coordinated shop-drawing connection details with wall finishes ,architraves floor threshold connection for lift portal. Additionally, fire stop application detail to be submitted separately for review and FLS approval.
7- Access ladder shall be submitted separately for approval.


Disclaimer: K&A Khatib & Alami – Saudi Consolidated Engineering's review and/or approval does not relieve the Contractor of its obligations under the Contract Documents. The Contractor remains fully responsible for the accuracy, completeness, coordination, and compliance of all submitted documents and executed works. Such review and/or approval shall not constitute acceptance of, or entitlement to, any additional time or cost

CONTROLLED COPY
MBL IFC
JEDDAH OPERA HOUSE PROJECT
QA/QC Department
MBL QAM
Engr. Mudassar Altaf


Refer to:
For Hooks design TQ-OPE-MBL-JCDC-00952
For Electrical Panels distribution: JOH-ICD-S5-01-056-XXX-02-SD-EL-011620
Attached wiring diagram opera lift
Attached Acoustic Letter: L-OTIS-MBL-OPE-26-0015

dar Dar Al-Handasah consultants (Shair and Partners)
Checked and Reviewed

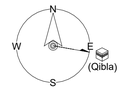

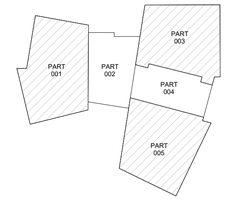

KEY PLAN

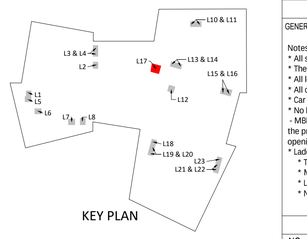

KEY PLAN

GENERAL NOTES: ALL LEVELS SHOWN ON THE DRAWING ARE CHART DATUM LEVELS PROJECT LEVEL+0.000 = +3.700 CHART DATUM.

Notes:
* All shop drawings have been extracted from the BIM federated model.
* The Contractor will carry out a site survey prior to execution.
* All levels indicated have been taken from the federated model.
* All car dimensions are in accordance with the approved TBE.
* Car interior finishes will be submitted under a separate submittal.
* No hoist-way pressurization is required for the Opera Building.
- MBL will provide a comprehensive Method Statement describing the procedure for filling all gaps and correcting / adjusting the rough openings for doors
* Ladder specification:
  * Type: Folding ladder (with a switch to protect the maintenance in the pit)
  * Material: Q235 tube (welding and painted yellow)
  * Length: About 1100mm above bottom landing
  * Note: the ladder will be divided into two parts to deliver

DRAWING / DOCUMENT REFERENCE

NO.	NUMBER	TITLE	REV.
01	L-17	JOH-HLA-S4-01-056-XXX-02-DR-AR-011120	F00
02		JOH-BHC-S4-01-056-XXX-XX-DR-VT-015001	
03		JOH-BHC-S4-01-056-XXX-XX-DR-VT-010001	
04		JOH-BHC-S4-01-056-005-ZZ-DR-VT-013001	
05		JOH-BHC-S4-01-056-005-ZZ-DR-VT-011001	
06		TQ-OPE-MBL-JCDC-00222	
07		JCD-OPE-MBL-MR-003-NMR-601-03	
08		JCD-OPE-MBL-MR-003-NMR-602-01	
09		TR-OPE-MBL-JCDC-06036	
10		TQ-OPE-MBL-JCDC-00952	

ELEV-L17 ELEVATOR GENERAL SPECIFICATIONS

LIFT NUMBER	Comments
CABIN INTERNAL SIZE(WXDXH)	2400X3500X2500
CAPACITY	5000Kg
CLEAR ENTRACE	2100X2400
CONTROL	VVVF
CONTROL SYSTEM	SIMPLEX FULL COLLECTIVE
COUNTERWEIGHT SAFETY	NO
DOOR TYPE	CLD
EMERGENCY EXITS	-
REAR OPENING	2 - FRONT OPENING : 1
HEAT RELEASE	-
HOISTWAY SIZE(HWXHD)	4375X4200
LIFT NUMBER	ELV.L17
LIGHTING SUPPLY	230V 60HZ
MIN.FLOOR HEIGHT	3070
NO. OF FLOOR	3
NO. OF OPENINGS	3
NO. OF UNITS	1
NON-STOP FLOORS	-
NON-STOP FLOORS NAMES	-
NUMBER OF PASSENGERS	66P
OVERHEAD	5400
PIT DEPTH	1800
POWER SUPPLY	400V 3P 60HZ
PRODUCT NO.	FOVF
RATED CURRENT(A)	75
FRONT OPENING	1
ROPING	4:1
SPEED(m/s)	1.00
START CURRENT(A)	150
SYSTEM POWER(KW)	33.1
TRAVEL	9975
USE	SERVICE LIFT

REACTIONS FORCE (KN)

R1=	196
R2=	146
R3=	261
R4=	75
R5=	45.6
PR=	152

LEGEND

HW	HOIST WAY WIDTH
HD	HOIST WAY DEPTH
CRH	CAR ROUGH HEIGHT
DOOR OP	DOOR OPENING
ROP	ROUGH OPENING
CW	CAR WIDTH
CD	CAR DEPTH
CH	CAR HEIGHT
DBG	DISTANCE BETWEEN GUARDRAIL
CWT	COUNTERWEIGHT
E&I PANEL	EMERGENCY & INSPECTION PANEL
G.O.V	CAR GOVERNOR
COP	CAR OPERATING PANEL
HBP	HALL POSITION INDICATOR

NOTE No.:
FRONT WALLS,FINISHES & ARCHITRAVES TO BE BUILT (BY MBL) AFTER THE INSTALLATION OF THE (LANDING) EXTERNAL DOORS.

IMPORTANT NOTE FOR MAIN CONTRACTOR.
FREEDOM OF ACCESS MUST BE AVAILABLE FOR POINT OF ENTRY INTO THE BUILDING UP TO THE ELEVATOR HOIST WAY AND THE FRONT WALLS OF THE HOIST WAY AT MAIN FLOOR TO BE LEFT OPEN FOR FULL WIDTH AND HEIGHT TO PERMIT ENTRY OF OUR EQUIPMENT.

REVIEWED BY DISCIPLINE	SIGNATURE	DATE
ARCHITECTURAL	MT	2026-08-11
STRUCTURAL	PC	2026-08-11
MECHANICAL	SH.A	2026-08-11
PLUMBING	SH.A	2026-08-11
ELECTRICAL	SH.A	2026-08-11
ICT	SH.A	2026-08-11
ADDITIONAL DISCIPLINES TO BE ADDED AS REQUIRED		

REV	DATE	BY	DESCRIPTION	CHK	APD
S00	08-AUG-2026	Usha	Issued for Approval	Sakr Salma	Ali Basit

DRAWING STATUS: CONSTRUCTION SHOPDRAWING

CLIENT: شركة وسط جدة للتطوير Jeddah Central Development Co.

LEAD DESIGN CONSULTANTS: Henning Larsen

LEAD ENGINEERING CONSULTANT: BURO HAPPOLD

PROJECT SUPERVISION CONSULTANT: K&A KHATIB & ALAMI

GENERAL CONTRACTOR: MBL

REVIEWER: dar

SUB CONTRACTOR: OTIS ELEVATOR COMPANY (SAUDI ARABIA) LIMITED

PROJECT: JEDDAH OPERA HOUSE

TITLE: OPERA BUILDING
VERTICAL TRANSPORTATION
PART 004
PLANS - LIFT SHAFT SHEET 02 OF 02 (L17)

SCALE @ A1:	CHECKED:	APPROVED:
As indicated	Sakr Salma	Ali Basit


PROJECT No:	DESIGNED:	DRAWN:	DATE:
440014	Usha	Usha	08-AUG-2026

DRAWING No: JOH-OTS-S5-01-056-004-ZZ-SD-VT-011021 REV: S00

MODEL FILE REF: JOH-OTS-S5-01-056-XXX-ZZ-M3-VT-010001


© JCDC

Wall built-up around the lift structural opening to be submitted for review and approval.

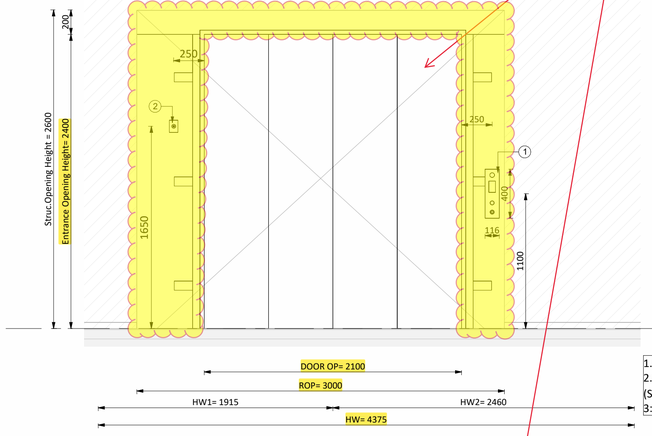

1.HB & HPI
2.HOLE ONLY RESERVED WHEN EPO APPLIED
(SUGGEST USER TO RESSERVE ∅40mm HOLE FOR PVC PIPE WIRING)
3:400×1700 THROUGH HOLE ONLY AT TOP FLOOR

1 Door Elevation At "G" Floor (REAR) - ELEV-L17
1 : 25

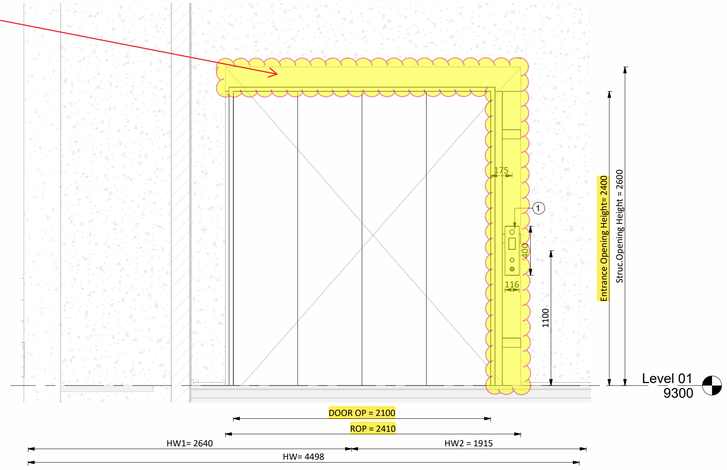


2 Door Elevation At "01" Floor (FRONT) - ELEV-L17
1 : 25


K&A ARCH COMMENTS :

1- Shaft size to be extracted from federated model.
2- Contractor must take in consideration as built dimensions and conditions prior execution.
3- FFL Levels shall match the federated model levels and as per site conditions.
4- Elevator Car Sizes/dimensions and Floors Being Served by the Elevators shall be as per approved TBE and further to OTIS letter TR-05809 and lift deviation letter.
5- Car interior finishes shall be submitted in a separate submission for approval.
6- Contractor to submit a complete coordinated shop-drawing connection details with wall finishes ,architraves floor threshold connection for lift portal. Additionally, fire stop application detail to be submitted separately for review and FLS approval.
7- Access ladder shall be submitted separately for approval.


Disclaimer: K&A Khatib & Alami – Saudi Consolidated Engineering's review and/or approval does not relieve the Contractor of its obligations under the Contract Documents. The Contractor remains fully responsible for the accuracy, completeness, coordination, and compliance of all submitted documents and executed works. Such review and/or approval shall not constitute acceptance of, or entitlement to, any additional time or cost

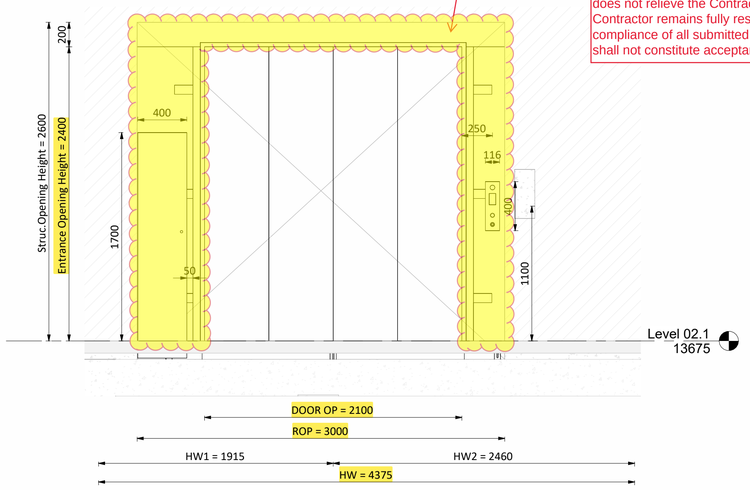

3 Door Elevation At "02" Floor (REAR) - ELEV-L17
1 : 25

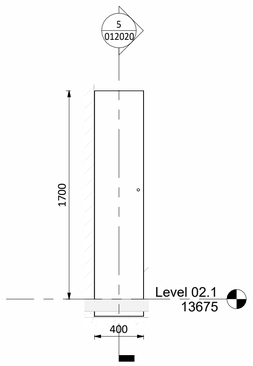

4 E&I SPOT DETAIL - ELEV - L17
1 : 25

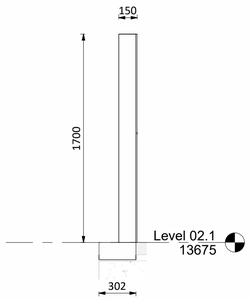



5 Cross-Section View B-B - ELEV - L17
1 : 25

SCEC – K&A Reviewed
Civil
Arch.
Elec.
ELV.
Mech.
Acoustic

SCEC – K&A Reviewed
Code B – Approved with Comments
(Do not Resubmit)


Simplex Units

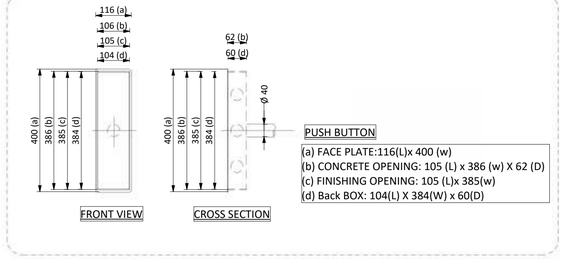

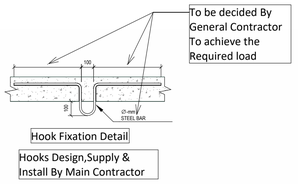

Hook Fixation Detail

Hooks Design,Supply & Install By Main Contractor

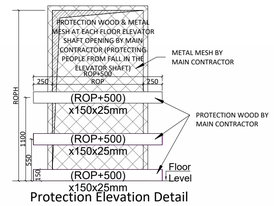


Protection Elevation Detail
At Each Elevator Shaft Opening

Refer to:
For Hooks design TQ-OPE-MBL-JCDC-00952
For Electrical Panels distribution: JOH-ICD-S5-01-056-XXX-02-SD-EL-011620
Attached wiring diagram opera lift
Attached Acoustic Letter: L-OTIS-MBL-OPE-26-0015

dar Dar Al-Handasah consultants (Shair and Partners)
Checked and Reviewed

LEGEND	
HW	HOIST WAY WIDTH
HD	HOIST WAY DEPTH
CRH	CAR ROUGH HEIGHT
DOOR OP	DOOR OPENING
ROP	ROUGH OPENING
CW	CAR WIDTH
CD	CAR DEPTH
CH	CAR HEIGHT
DBG	DISTANCE BETWEEN GUARDRAIL
CWT	COUNTERWEIGHT
E&I PANEL	EMERGENCY & INSPECTION PANEL
G.O.V	CAR GOVERNOR
COP	CAR OPERATING PANEL
HBP	HALL BUTTON POSITION INDICATOR

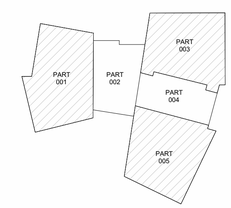

KEY PLAN

GENERAL NOTES: ALL LEVELS SHOWN ON THE DRAWING ARE CHART DATUM LEVELS PROJECT LEVEL+0.000 = +3.700 CHART DATUM.

Notes:
* All shop drawings have been extracted from the BIM federated model.
* The Contractor will carry out a site survey prior to execution.
* All levels indicated have been taken from the federated model.
* All car dimensions are in accordance with the approved TBE.
* Car interior finishes will be submitted under a separate submittal.
* No hoist-way pressurization is required for the Opera Building.
- MBL will provide a comprehensive Method Statement describing the procedure for filling all gaps and correcting / adjusting the rough openings for doors
* Ladder specification:
  * Type: Folding ladder (with a switch to protect the maintenance in the pit)
  * Material: Q235 tube (welding and painted yellow)
  * Length: About 1100mm above bottom landing
  * Note: the ladder will be divided into two parts to deliver

DRAWING / DOCUMENT REFERENCE

NO.	NUMBER	TITLE	REV.
01	L-17	JOH-HLA-S4-01-056-XXX-02-DR-AR-011120	F00
02		JOH-BHC-S4-01-056-XXX-XX-DR-VT-015001	
03		JOH-BHC-S4-01-056-XXX-XX-DR-VT-010001	
04		JOH-BHC-S4-01-056-005-ZZ-DR-VT-013001	
05		JOH-BHC-S4-01-056-005-ZZ-DR-VT-011001	
06		TQ-OPE-MBL-JCDC-00222	
07		JCD-OPE-MBL-MR-003-NMR-601-03	
08		JCD-OPE-MBL-MR-003-NMR-602-01	
09		TR-OPE-MBL-JCDC-06036	
10		TQ-OPE-MBL-JCDC-00952	

REVIEWED BY DISCIPLINE	SIGNATURE	DATE
ARCHITECTURAL	MT	2026-08-11
STRUCTURAL	PC	2026-08-11
MECHANICAL	SA	2026-08-11
PLUMBING	SA	2026-08-11
ELECTRICAL	SA	2026-08-11
ICT	SA	2026-08-11
ADDITIONAL DISCIPLINES TO BE ADDED AS REQUIRED		

REV	DATE	BY	DESCRIPTION	CHK	APD
S00	08-AUG-2026	Usha	Issued for Approval	Sakr Salma	Ali Basit

DRAWING STATUS: CONSTRUCTION SHOPDRAWING

CLIENT: شركة وسط جدة للتطوير Jeddah Central Development Co.

LEAD DESIGN CONSULTANTS: Henning Larsen

LEAD ENGINEERING CONSULTANT: BURO HAPPOLD

PROJECT SUPERVISION CONSULTANT: K&A Khatib & Alami

GENERAL CONTRACTOR: MBL

REVIEWER: dar

SUB CONTRACTOR: OTIS ELEVATOR COMPANY/ SAUDI ARABIA LIMITED — OTIS

PROJECT: JEDDAH OPERA HOUSE

TITLE: OPERA BUILDING
VERTICAL TRANSPORTATION
PART 004
ELEVATIONS - LIFT SHAFT (L17)


SCALE @ A1:	CHECKED:	APPROVED:
As indicated	Sakr Salma	Ali Basit


PROJECT No:	DESIGNED:	DRAWN:	DATE:
440014	Usha	Usha	08-AUG-2026

DRAWING No: JOH-OTS-S5-01-056-004-ZZ-SD-VT-012020 REV: S00

MODEL FILE REF: JOH-OTS-S5-01-056-XXX-ZZ-M3-VT-010001


© JCDC

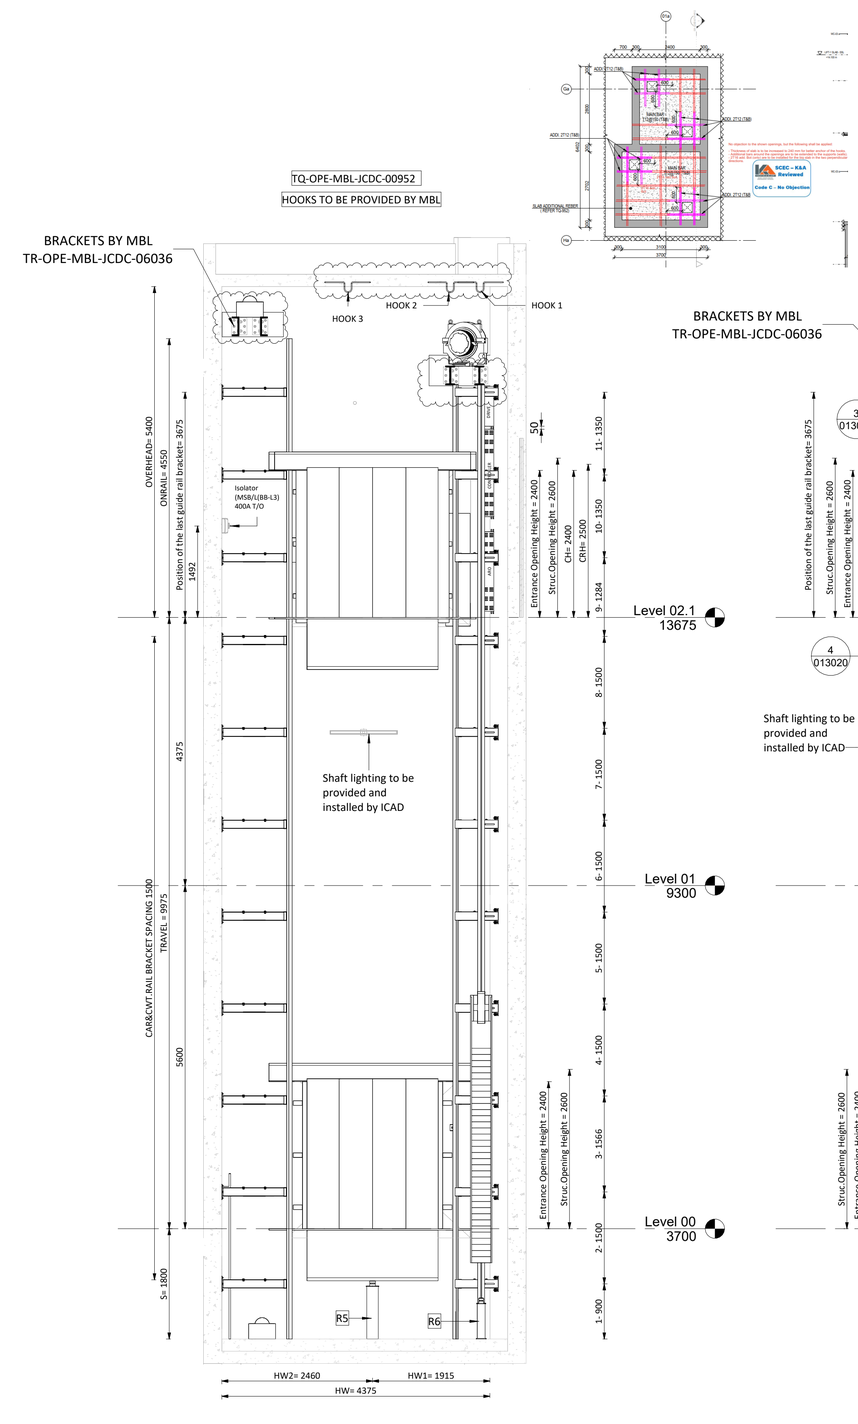

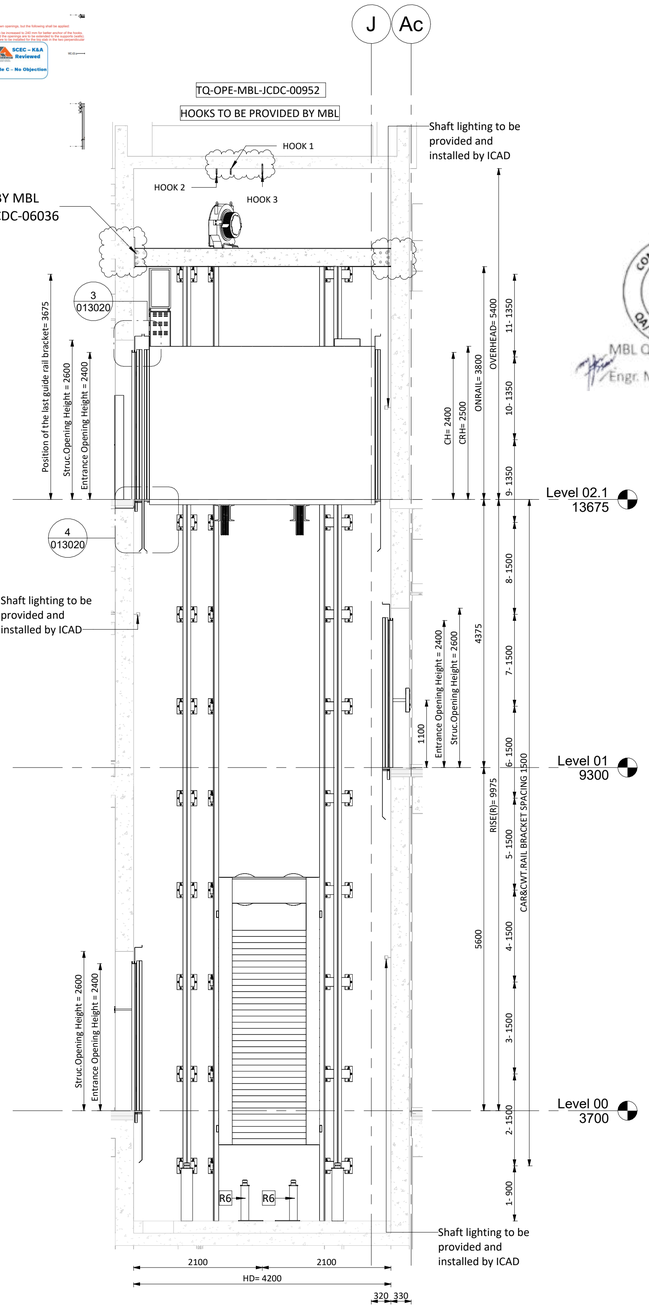


1 Section "A" - ELEV-L17
1 : 50


2 Section "B" - ELEV-L17
1 : 50

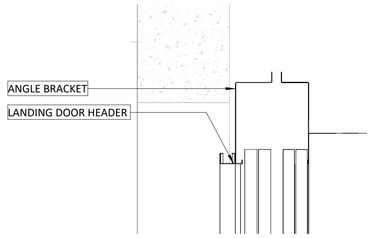


3 Landing Door Header Detail - ELEV -L17
1 : 10

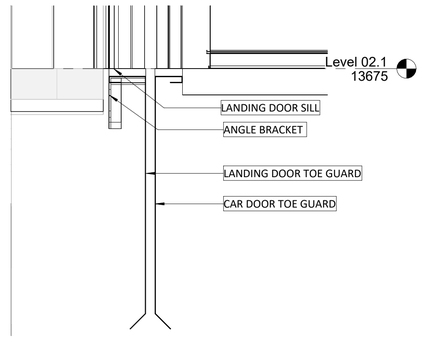

4 Landing Door Bottom Detail - ELEV-L17
1 : 10

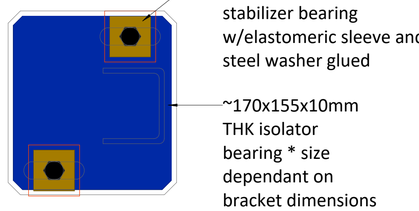



A DETAIL A - COMBINED BRACKET BASE PLATE_ELEV-L17
1 : 3

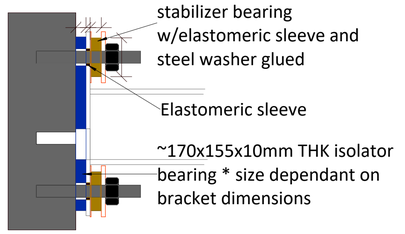

A' DETAIL A - COMBINED BRACKET PLAN_ELEV-17
1 : 3

LEGEND	
HW	HOIST WAY WIDTH
HD	HOIST WAY DEPTH
CRH	CAR ROUGH HEIGHT
DOOR OP	DOOR OPENING
ROP	ROUGH OPENING
CW	CAR WIDTH
CD	CAR DEPTH
CH	CAR HEIGHT
DBG	DISTANCE BETWEEN GUARDRAIL
CWT	COUNTERWEIGHT
E&I PANEL	EMERGENCY & INSPECTION PANEL
G.O.V	CAR GOVERNOR
COP	CAR OPERATING PANEL
HBP	HALL BUTTON POSITION INDICATOR

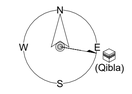

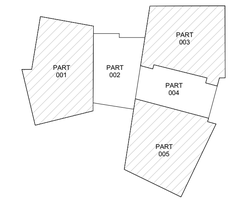

KEY PLAN

GENERAL NOTES: ALL LEVELS SHOWN ON THE DRAWING ARE CHART DATUM LEVELS PROJECT LEVEL+0.000 = +3.700 CHART DATUM.

DRAWING / DOCUMENT REFERENCE

NO.	NUMBER	TITLE	REV.
01	JOH-HLA-S4-01-056-XXX-02-DR-AR-011120	L-17	F00
02	JOH-BHC-S4-01-056-XXX-XX-DR-VT-015001		
03	JOH-BHC-S4-01-056-XXX-XX-DR-VT-010001		
04	JOH-BHC-S4-01-056-005-ZZ-DR-VT-013001		
05	JOH-BHC-S4-01-056-005-ZZ-DR-VT-011001		
06	TQ-OPE-MBL-JCDC-00222		
07	JCD-OPE-MBL-MR-003-NMR-601-03		
08	JCD-OPE-MBL-MR-003-NMR-602-01		
09	TR-OPE-MBL-JCDC-06036		
10	TQ-OPE-MBL-JCDC-00952		
11	SD-OPE-MBL-JCDC-02134	CDM Rail Bracket Acoustic Pads Typical Details For Opera And Carpark Lifts	

REVIEWED BY DISCIPLINE	SIGNATURE	DATE
ARCHITECTURAL	MT	2026-09-02
STRUCTURAL	PE	2026-09-02
MECHANICAL	SH.A	2026-09-02
PLUMBING	SH.A	2026-09-02
ELECTRICAL	SH.A	2026-09-02
ICT	SH.A	2026-09-02
ADDITIONAL DISCIPLINES TO BE ADDED AS REQUIRED		

REV	DATE	BY	DESCRIPTION	CHK	APD
S00	01-SEP-2026	Usha	Issued for Approval	Sakr Salma	Ali Basit

DRAWING STATUS: CONSTRUCTION SHOPDRAWING

CLIENT: شركة وسط جدة للتطوير Jeddah Central Development Co.

LEAD DESIGN CONSULTANTS: Henning Larsen

LEAD ENGINEERING CONSULTANT: BURO HAPPOLD

PROJECT SUPERVISION CONSULTANT: SCEC – K&A

GENERAL CONTRACTOR: MBL

REVIEWER: dar

SUB CONTRACTOR: OTIS ELEVATOR COMPANY SAUDI ARABIA LIMITED. OTIS

PROJECT: JEDDAH OPERA HOUSE

TITLE: OPERA BUILDING
VERTICAL TRANSPORTATION
PART 004
SECTIONS - LIFT SHAFT (L17)

SCALE @ A1:	CHECKED:	APPROVED:
As indicated	Sakr Salma	Ali Basit

PROJECT No:	DESIGNED:	DRAWN:	DATE:
440014	Usha	Usha	01-SEP-2026

DRAWING No: JOH-OTS-S5-01-056-004-ZZ-SD-VT-013020 REV: S00

MODEL FILE REF: JOH-OTS-S5-01-056-XXX-ZZ-M3-VT-010001

© JCDC

CONTROLLED COPY
MBL IFC
JEDDAH OPERA HOUSE PROJECT
QA/QC Department
MBL QAM
Engr. Mudassar Altaf

SCEC – K&A Reviewed
Civil
Arch.
Elec.
ELV.
Mech.
Acoustic

SCEC – K&A Reviewed
Code B – Approved with Comments
(Do not Resubmit)

Refer to:
For Hooks design TQ-OPE-MBL-JCDC-00952
For Electrical Panels distribution: JOH-ICD-S5-01-056-XXX-02-SD-EL-011620
Attached wiring diagram opera lift
Attached Acoustic Letter: L-OTIS-MBL-OPE-26-0015

dar Dar Al-Handasah Consultants (Shair and Partners)
Checked and Reviewed